


845 1P

INDEXED ON MAP

— survey
Boher creek Twp
V M S 9890

Stone on broken tile.

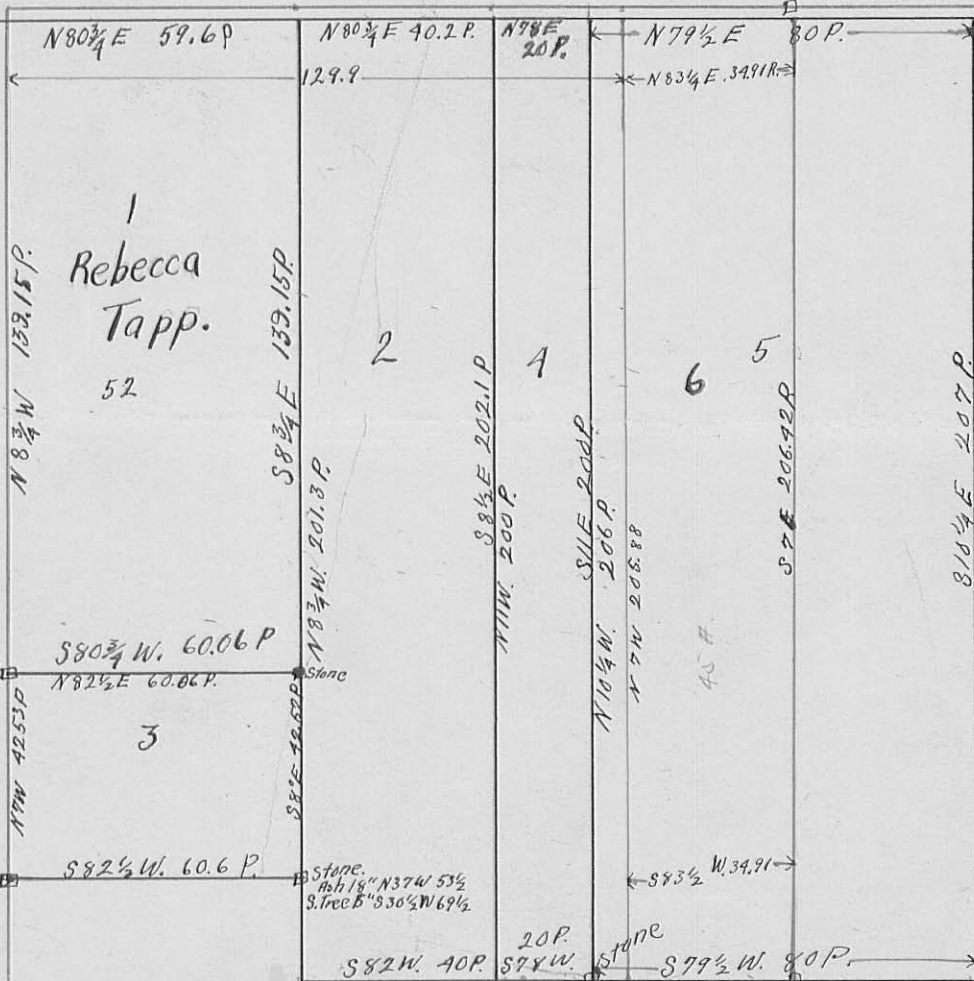

$$\begin{array}{r} 1/140.2 \quad (35.05) \\ 12 \\ \hline 20 \\ 20 \\ \hline 20 \end{array}$$

$$\begin{array}{r} 15.10 \\ 35.25 \\ \hline 50.25 \end{array}$$

Stone
Red 0.15" N31W 54 1/2

Stone

Stone
Sugar 12" S16 1/2 E 44 1/2
" 18" N8 W 44 1/2

Stone
Ash 18" N37W 53 1/2
S. Tree 5" S30 1/2 W 69 1/2

Stone

Limestone