

Road 139

Bokescreek Twp.


see Road 139 Plan X-139

1800

INDEXED ON MAP

Oct 30, 1937
Clear - Warm
F. Wright
G. Wilson

70

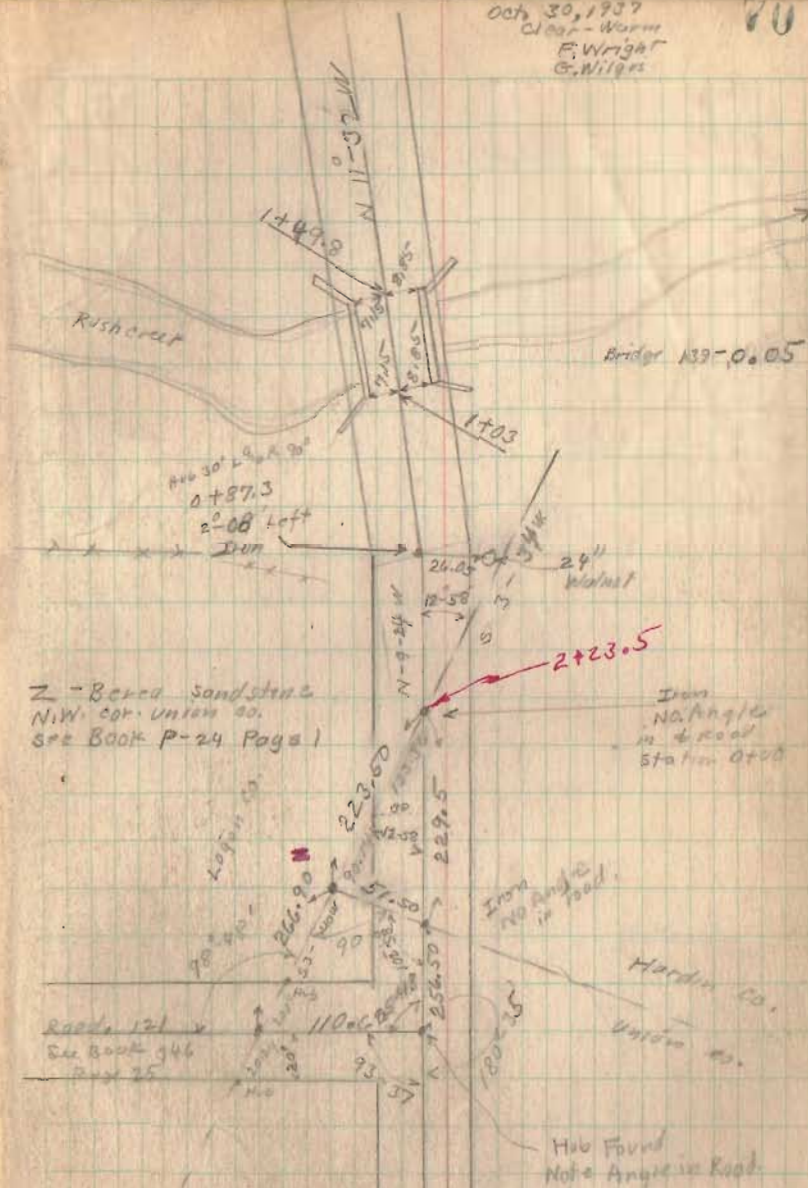

Road 139

1800

INDEXED ON MAP

71

