

3-3-39

G. Hilgus
M. Jones
H. Lee
M. James
S. Debie

Road # 138

Surveyed w/ stakes set

11+00 25' from \pm on R. & L.

stakes set ever 100'

10+00 By order of Trustees

No Record.

9+00

V.M.S. 12112

8+00

7+00

6+00

5+00

4+00

3+00

2+00

1+00

0+00

Iron set \pm of 48 & 138 at 0+00

1" Bar Iron 11/16" O.C.D.

71

V.M.S.

12112

V.M.S.

12112

\pm of Road is Survey Line

3600

INDEXED ON MAP

Harold R. Mouser

Road # 48

Survey
LINE

8" Sycamore

0" Maple Tree

R.E. Fillingar

Everett J. Hatcher

20" Elm

CO. Line
Stone

Iron set
of Rd 48-138

4.26
4.25
4.25

24.5
24.5

23.36

14.3 14.9

13.3 15.2

65

24+00

23+00

22+00

21+00

20+00

19+00

18+00

17+00

16+00

15+00

14+00

13+00

12+00

72

11.5 • 17.8

John Willard
~~x x x x~~ 47+
Harold M. 2V35X

Geo. Wallace
~~+17X x x x~~

36+00

35+00

34+00

33+00

32+00

31+00

30+00

29+00

28+00

27+00


26+00

25+00

/

18.6 • 12.7

17.7 • 13.5

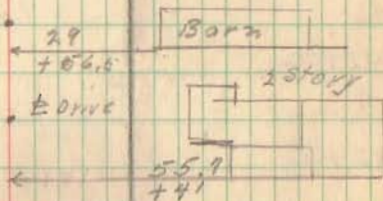

49000

49+00

48+00

47+00

46+00

45+00

44+00

43+00

42+00

41+00

40+00

39+00

38+00

37+00

74

2 story

195700

485

195700

24
+695

Baron

61+00

60+00

59+00

58+00

57+00

56+00

55+00

54+00

53+00

52+00


51+00

50+00

18.2 14.20

19.00 14.00


+59

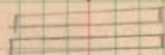

20" over Flank Vit
20" Count of Ditch

20.00 15.6

Herbert
Anna Williams
49+92
Geo. Wallace

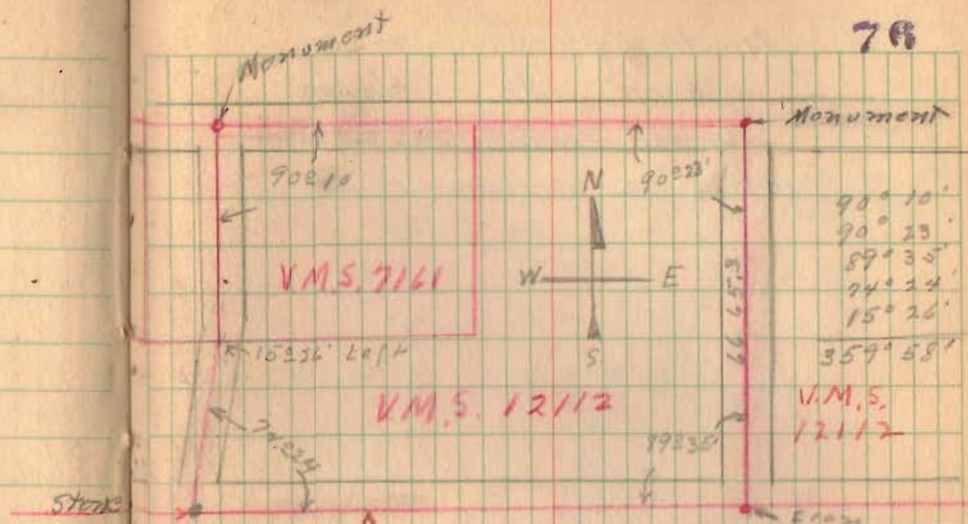

THIS IS SURVEY LINES

V.M.S. 9959

C.K. E. HOTT

MONUMENT
R.H. McLeod
11115 D.D.

Road # 117

+65.3

90° 23'
192.27

John Willauer

15.4 → 14.8

~~Ann~~ Willauer
Herbert

V.M.S. 12112

V.M.S. 12112

E of Road is Survey Line

6635
49.93
1643
11
1643
1643
1807.50
124240
64700
43860
11340

66400

65400

64400

63400

62400