

Lot 61 DeGraft
 25' off N. side of Lot 61
 for Telephone Co.

Lots as shown in Plat
 Book see Page 69
 for survey
 Regular lots 66' X 132'



1637

INDEXED ON MAP

Feb. 22, 1935

Stow - Main
 F. Wright
 E. Core

68

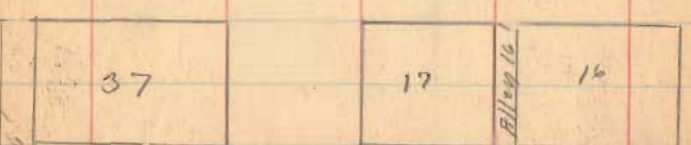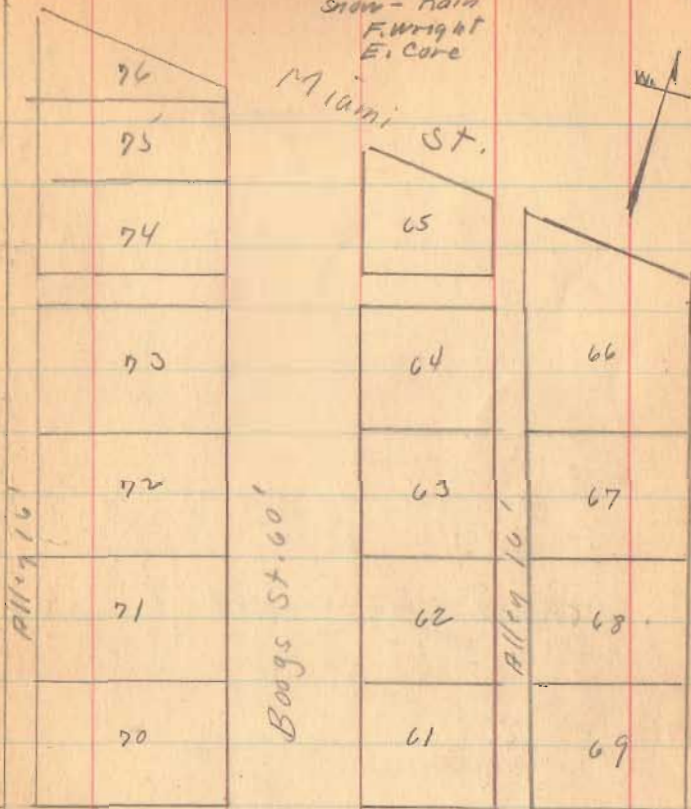

For survey of
 This Block see
 Ferry Survey
 No. 638 Book 419
 Page 30-31


Lot 61 DeGraff.

25 X 132 - Hs staked


1637

INDEXED ON MAP

2-22-35

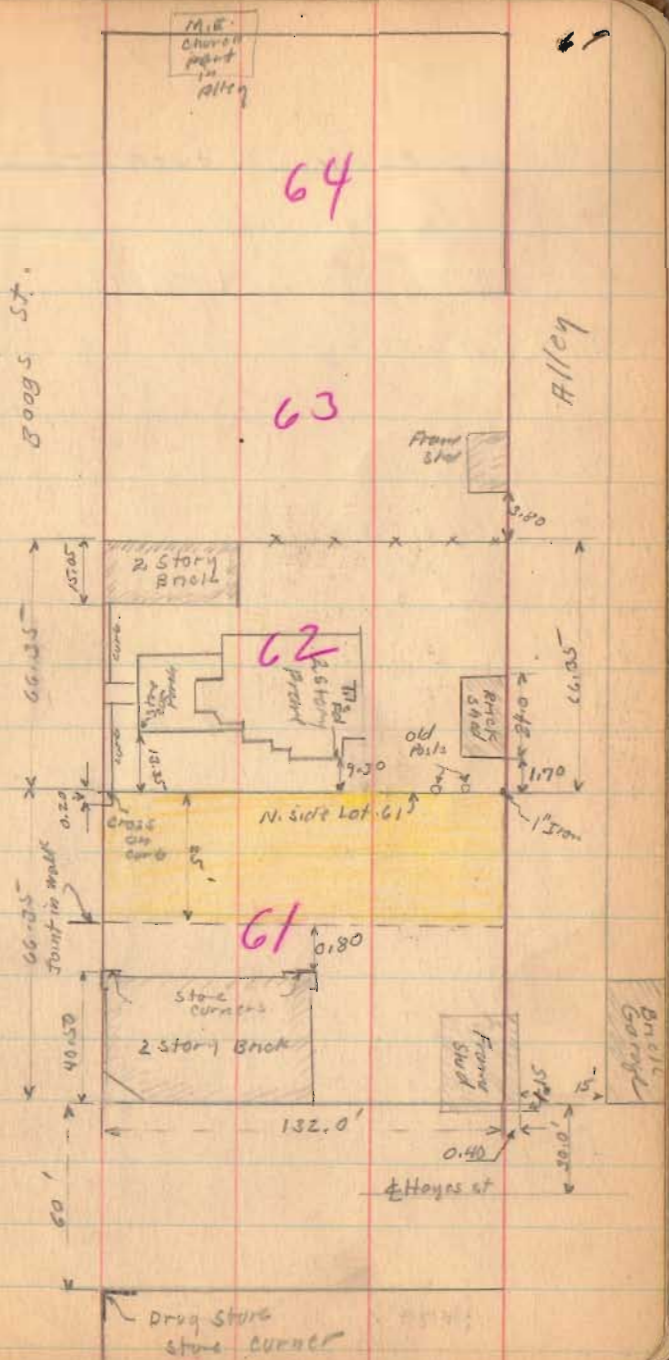

MAIN ST. 60'

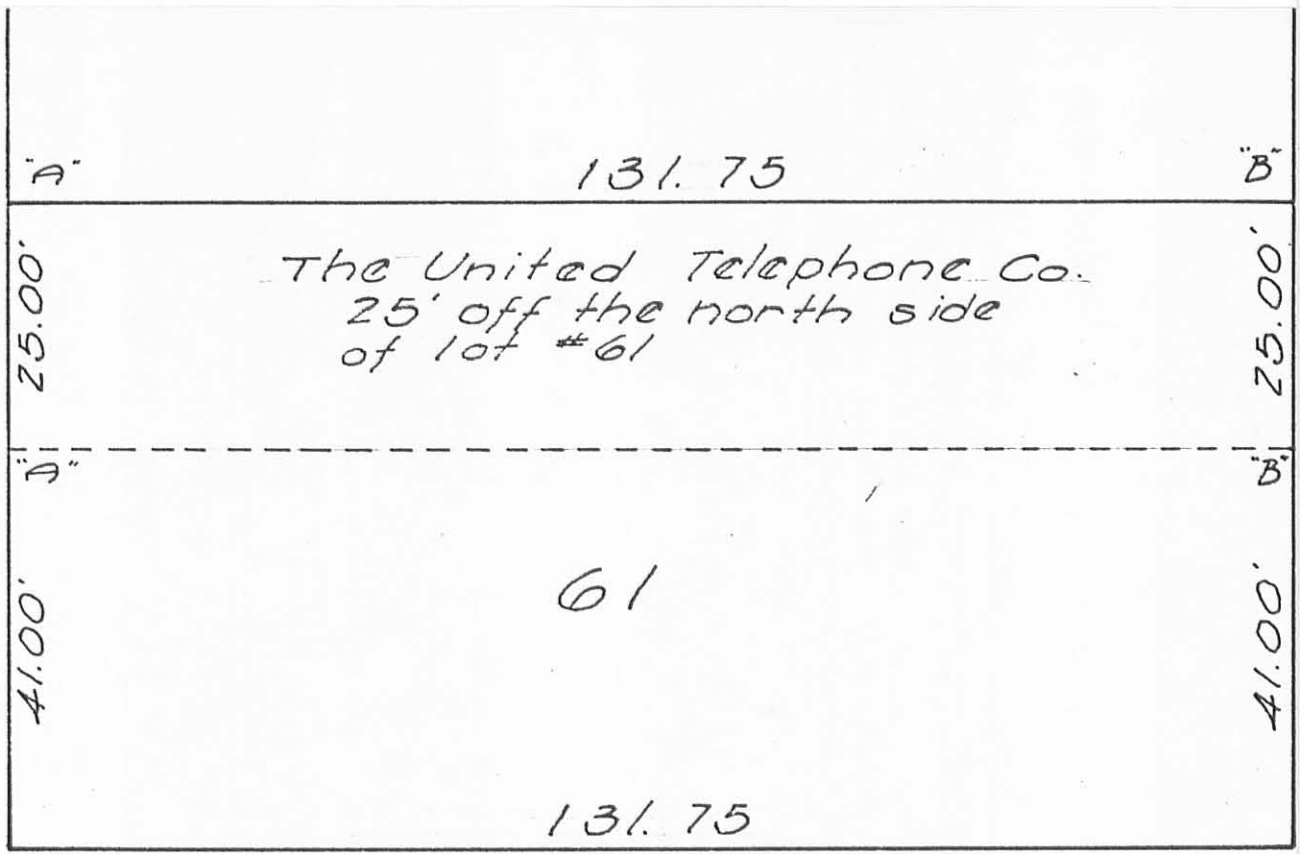

HAYES ST. 60'

INDEXED ON MAP
1637 IP

SURVEY OF PART LOT 61
DEGRAFF, OHIO
FOR
THE LIMA TELEPHONE Co.
DECEMBER 17, 1966
SCALE 1" = 20'

Dan L. Dodson
Dan L. Dodson
Reg. Surveyor 4270
Bellefontaine, Ohio

"A" = Chiseled + in Conc.
"B" = 3/4" # Bar Set