


July-17-1935
High day
F. Wright
E. Carr

St. Corner De Graff Ohio
T. J. Reardon Lot.

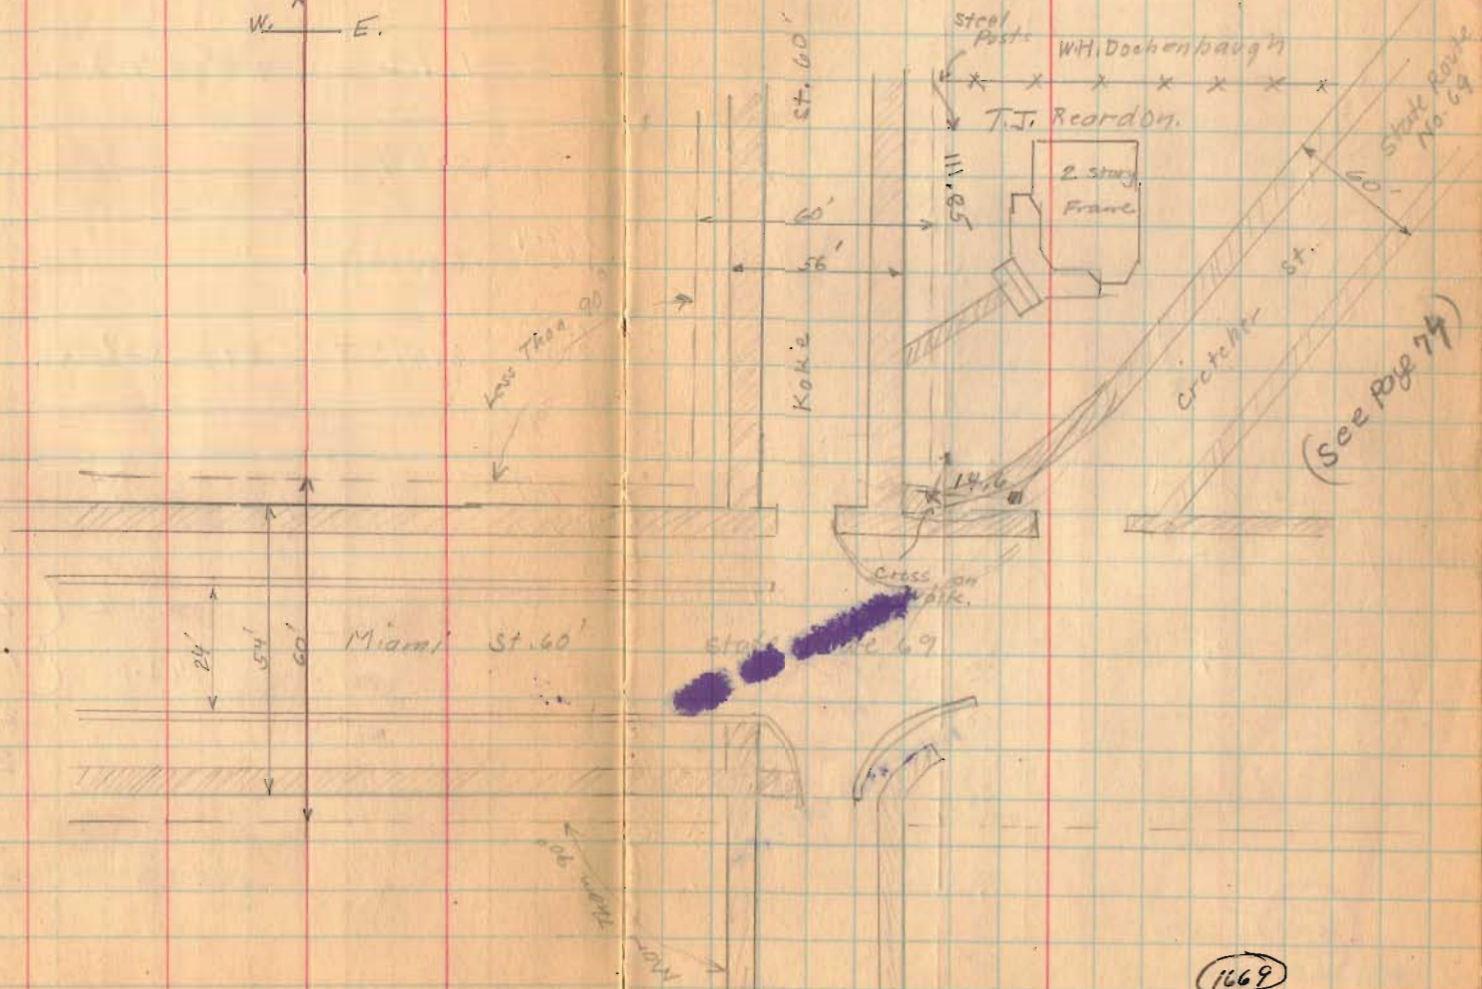

1669