

COPY

Telephone: 251 Loveman Avenue
 Tu 5-8248 Worthington, Ohio


JOHN CIRCLE
 ENGINEER - SURVEYOR

Civil Engineer
 Professional Surveyor

Reg. No. 19131
 Reg. No. 4340

OWNER MARIE SHAWAN Subdivision ACREAGE Deed 216 Page 257

ADDRESS DEGRAFF, OHIO County LOGAN Lot No. Plat Page

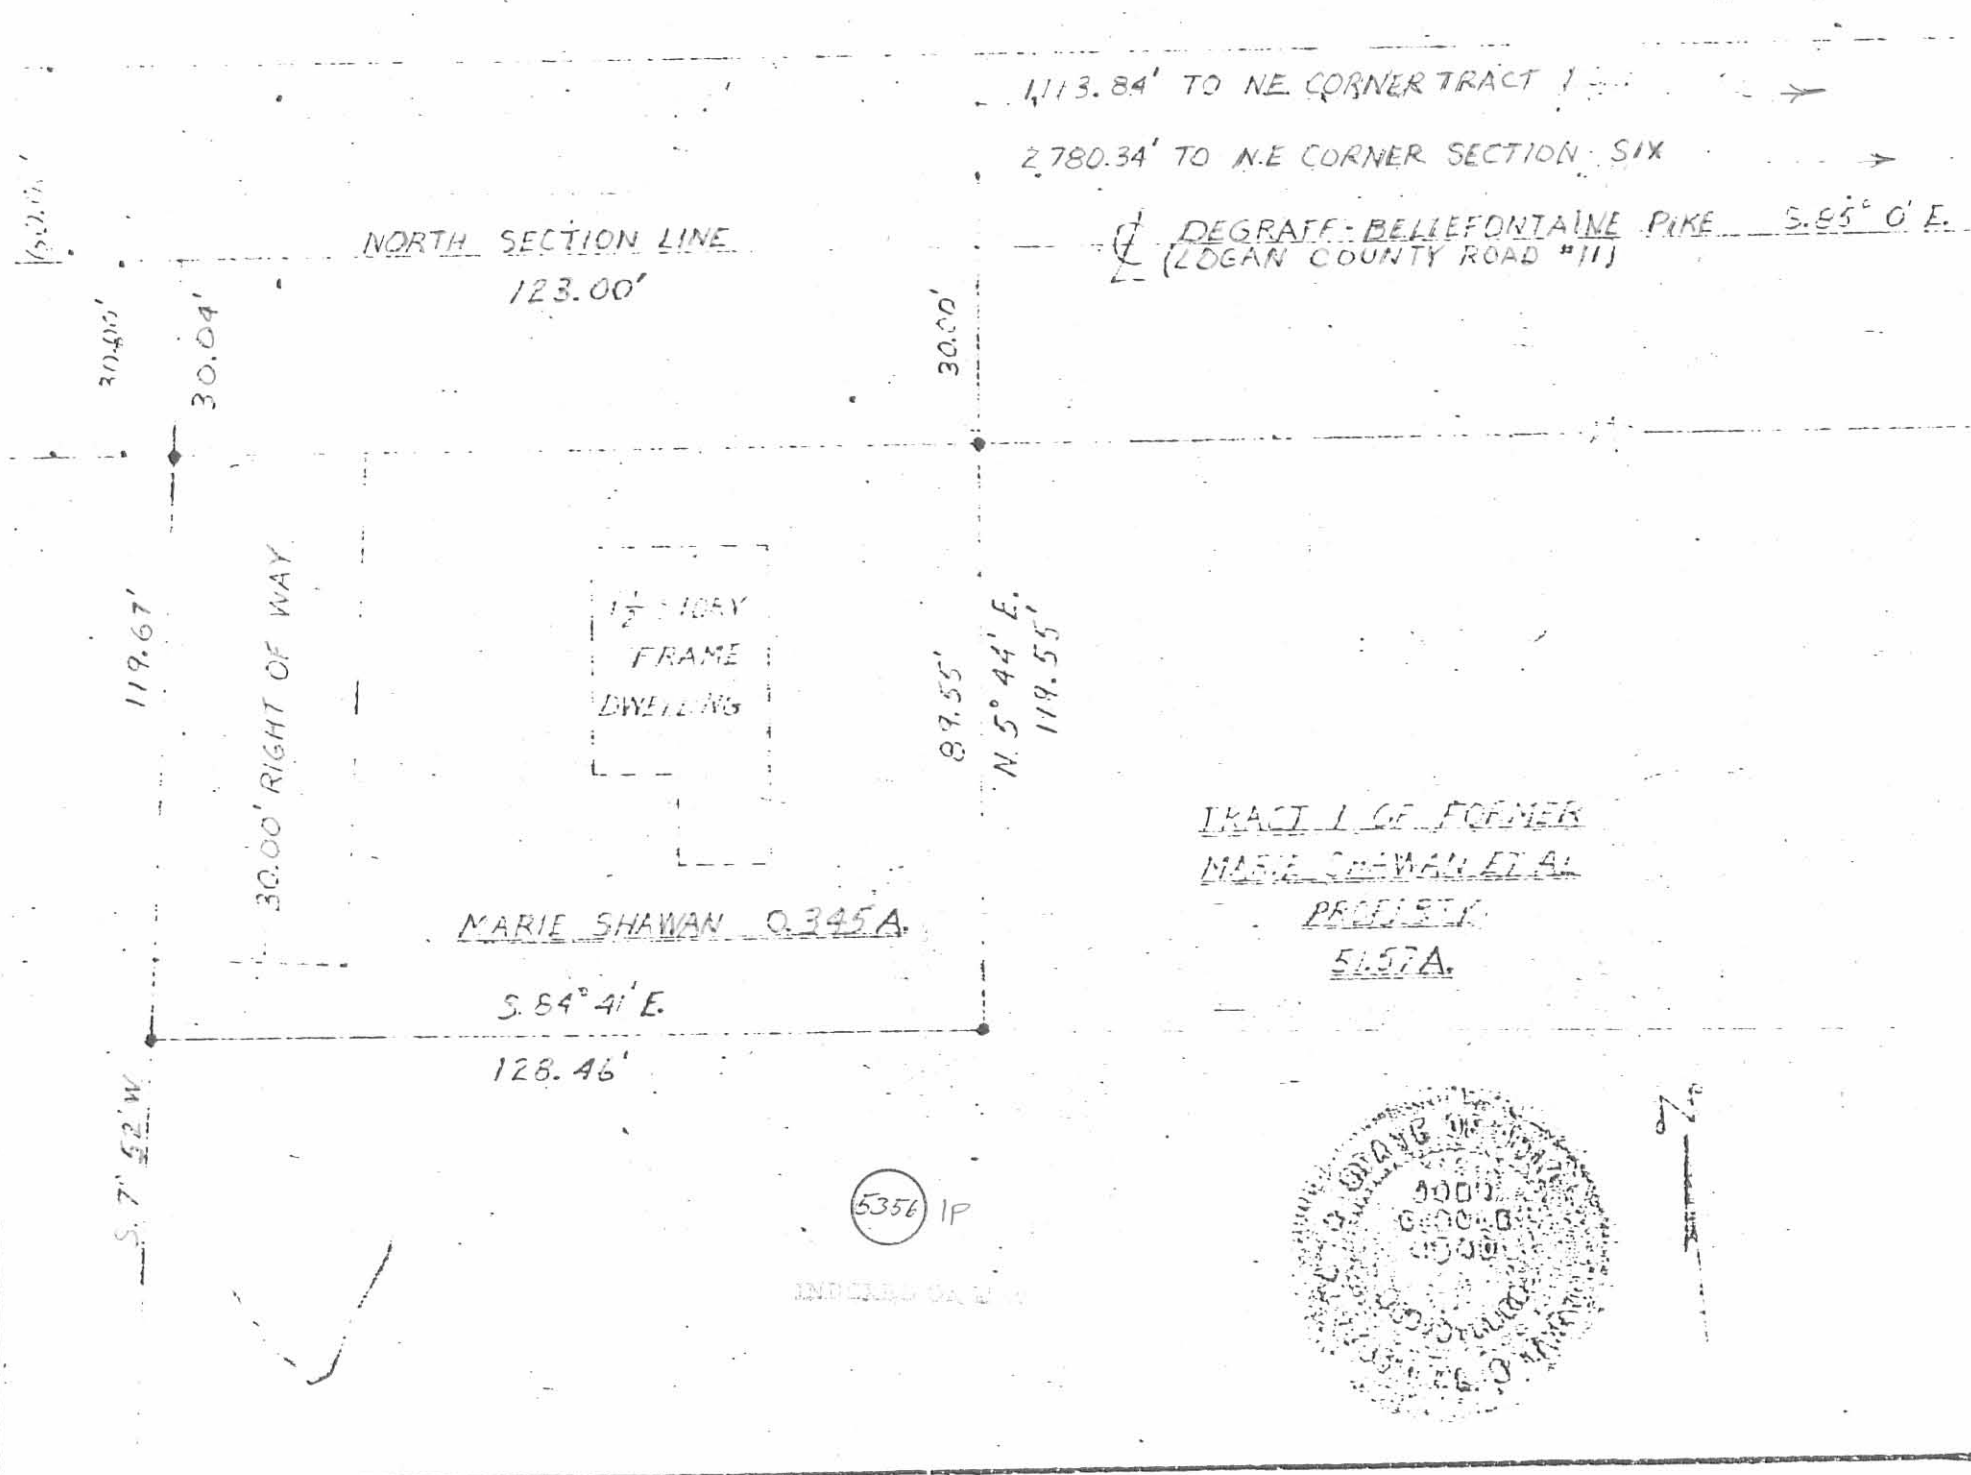

To all parties interested in title to premises: I hereby certify that the foregoing drawing was prepared from an actual survey of the premises and shows the location of the boundaries

Drawn By John Circle Scale As Shown LEGEND: Exp. Iron Pin o New Iron Pin •

Checked By John Circle Dwg. No. 5157A Date 2/10/10 JOHN CIRCLE, ENGINEER, SURVEYOR