


84
 97 912 275 (31.2)
 2736
 912
 2736
 33.45
 5.4
 31.2
 80
 11.2
 Survey for PC Sharp
 R.M.S. 4689 East Liberty Ohio

- A dug hole 3'x3'x3' deep. found nothing.
 set 1" pipe 30" long in top old car post
 B 1/2"x24" pipe set 27' from A
 as line with C.
 C 1/4" iron bar (found)
 D searched for iron bar found nothing
 3/4"x30" pipe (set)
 B D is parallel to old $\frac{1}{2}$ T & O.C.

84
 62
 65-91'
 111.5'
 152.2
 80
 115.3
 81
 24.2
 C.A. Moskeep
 C.A. Miller
 385
 10-15-96
 10-16-96

168.3
 28.5
 196.8
 1
 186
 22.5
 163.5
 11

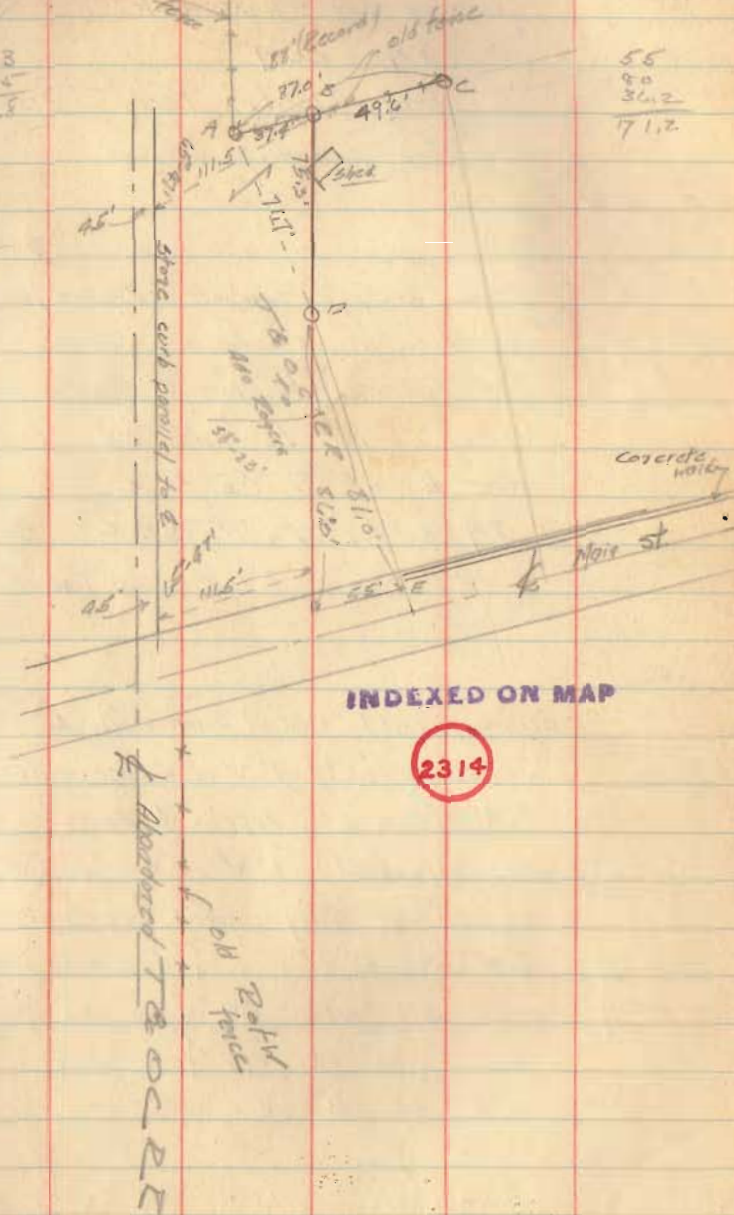

55
 80
 36.2
 171.2

90
84
82
219 to 7/2

Journey for Minnie Coker

RMS 9689

East Liberty Perry Trip

See preceding page

- E 1" pipe (set) on top of $\frac{3}{4}$ " x 24" bolt.
21' from "D" 55 feet "F" which is
80' parallel to Main St from a
line parallel to and 33' from
the E of T Co O.C.
J M Hamilton to T Co C 97-22
10-6-02 (E) pipe set 1' W of walk

H

I

- J Iron pipe (set) 1' W of W line walk 40' from I

K Iron pipe (set) 1' W of W edge walk

91.4' from L, Approx E drive

L Iron pipe (set) 1' W of W edge walk

of S line alley approx old fence line

M Pipe (set) 40' from a or line with ABC


N Iron bolt (set) 193' from walk line

in line of old fence post

O Old 10" post. ok 193' from W. line
walk

P Pipe (set) on fence line to S, distance
from RR lot & fence

CA Lockup
CA

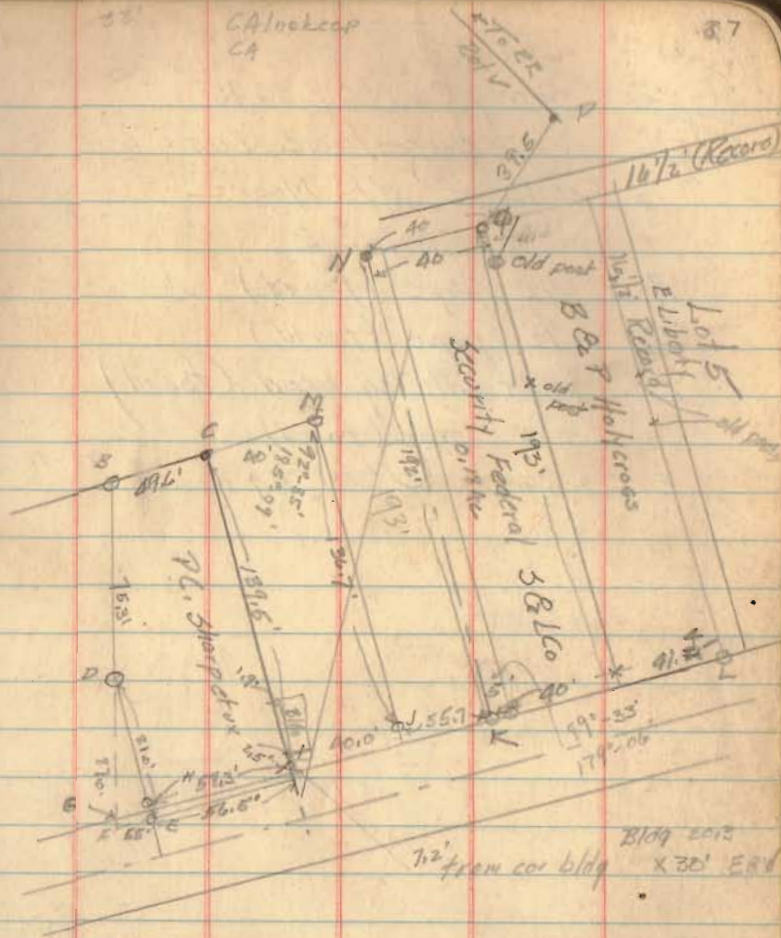

INDEXED ON MAP

2314