


Bridge 216-1.20

A B D E F Hubs in Creek

C Tack in floor 45

city

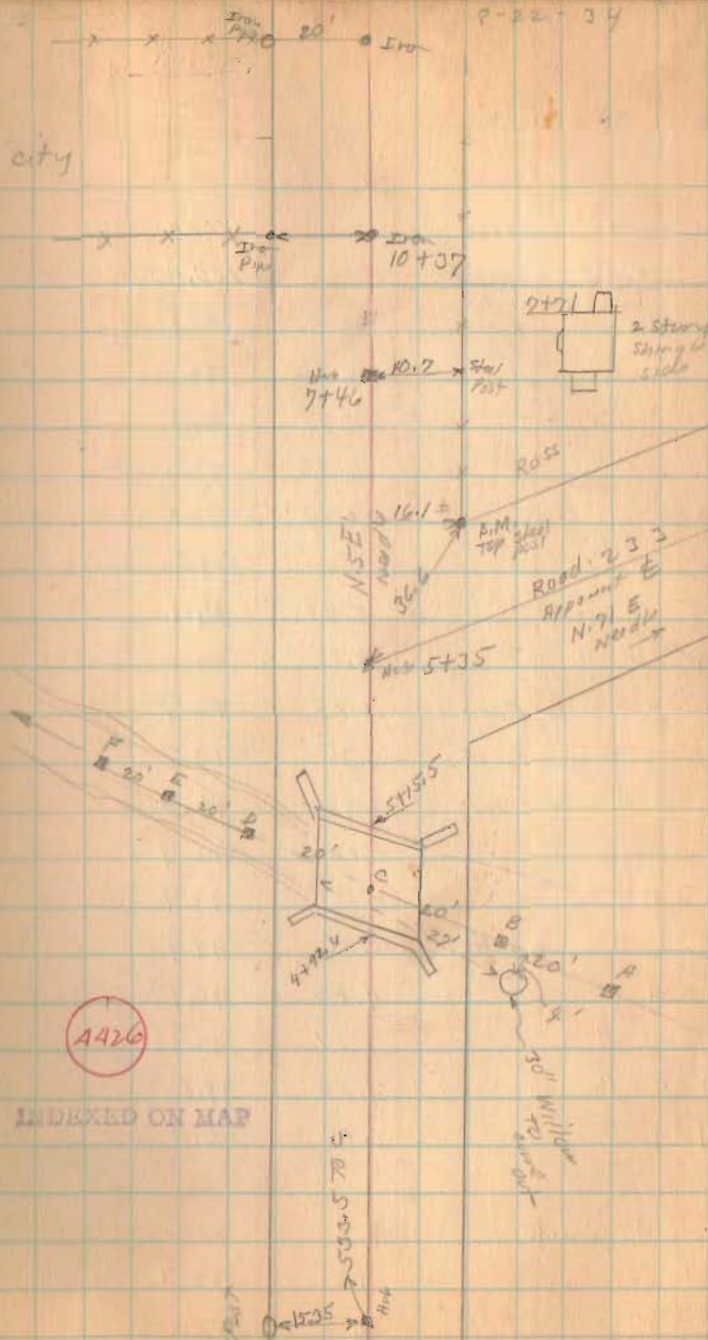

Bridge 216-1.20

25.28  
19.75  
50  
104.03

25.28  
19.75  
50  
93.03

Oct. 26, 1934  
Cool 25  
F. Wright  
J. Montgomery

