

CARLSON TO DERR

JULY, 1974

The following described real estate situated in Section 12, Town 3, Range 14, Harrison Township, Logan County, Ohio and being more particularly described as follows:

Beginning at an iron bar in the centerline of County Highway 32 and the east right-of-way line of the Penn Central Railroad; thence with said east right-of-way line on a 6570.2 foot radius curve to the right, the chord of which bears N.30°20.4'W. 623.7 feet, to an iron bar; thence S.85°48'E. 353.6 feet to an iron bar in the centerline of C.H. 32; thence with said centerline S.4°12'W. 513.73 feet to the place of beginning.

Containing 2.16 acres more or less.


The above described 2.16 acres being in the south part of M. W. Carlson's 6.50 acre tract.

I hereby certify that the above is a true and accurate description of a survey made by me.

Leslie H. Geeslin
Registered Surveyor 5248
Rushsylvania, Ohio 43327



CARLSON TO DERR
 JULY, 1974
 SEC. 12 - T. 3 - R. 14
 HARRISON TOWNSHIP
 LOGAN COUNTY, OHIO
 SCALE 1" = 100'

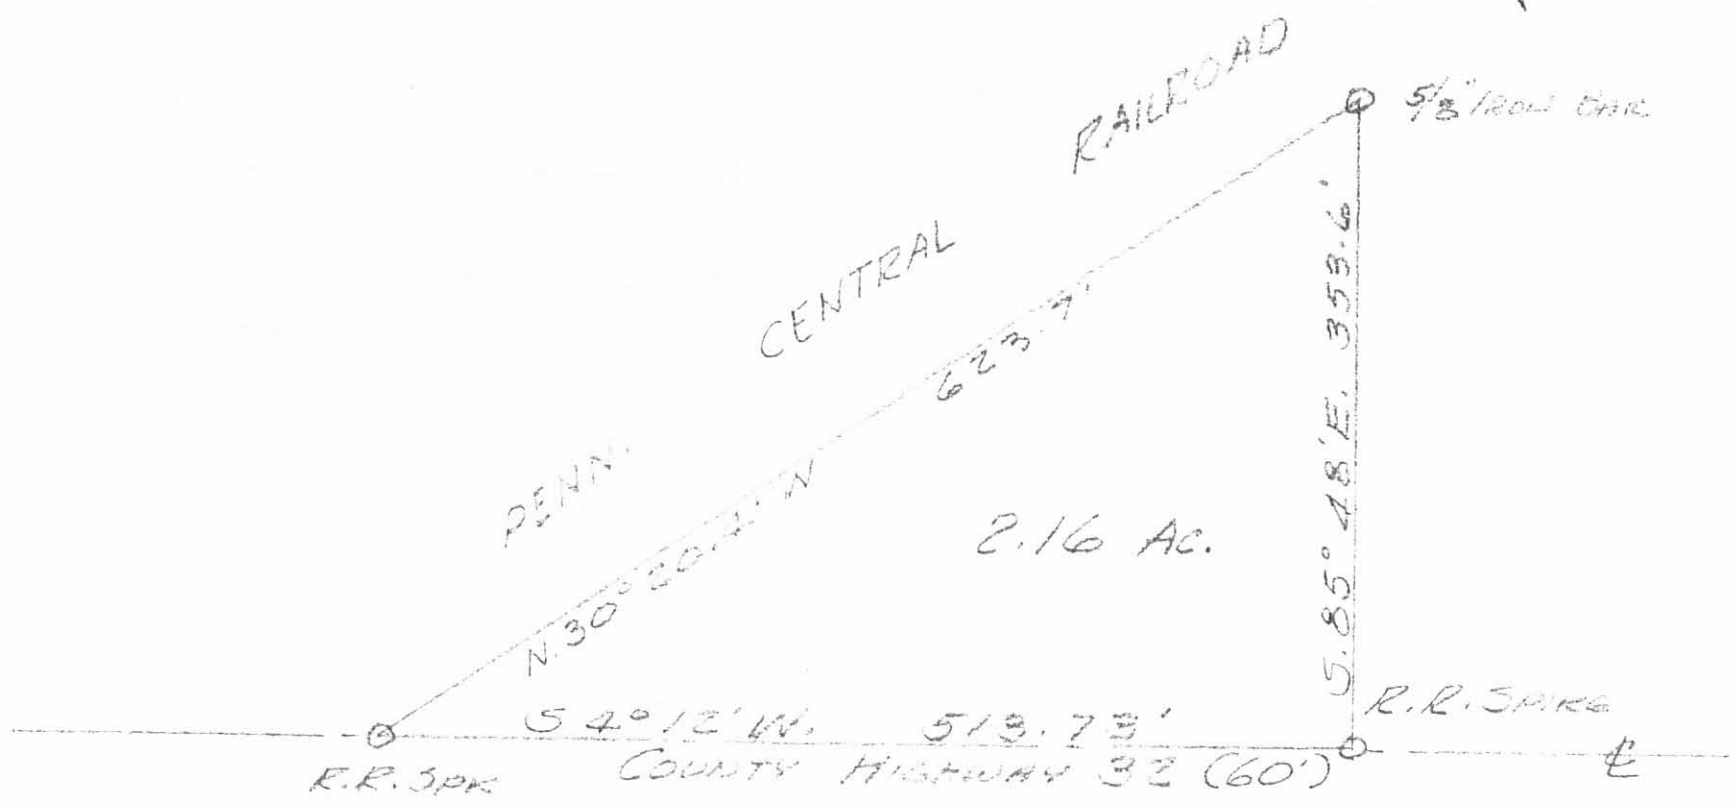

INDEXED ON MAP

LESLIE H. GUESLIN
 REG. SURVEYOR 5028
 RUSHSVANIA, OHIO