

corner of sec. 23. white oak 24 inches in diam. or 82 W 28 links
 dist. thence west between sec. 23 & 24 232 poles to the beginning
 containing 587 3/4 acres. The division line begins at a white
 oak white oak 15 inches in diam. west 11 links a white oak 18 inches
 in diam. S 73 E 21 links dist. in the north line of sec 23 26 poles from
 the N.E. corner thereof thence W 12 1/2 E 116 poles to a white oak thence
 S 24 E 58 poles to a stone in a prairie thence south 58 poles to near the
 bank of Mad River thence S 12 1/2 E 88 poles to the south line of said
 sec. a black oak 12 inches in diam. S 76 E 23 links dist. - The part
 on the west side of the division line contains 347 3/4 acres - the other
 240 acres of


James Williamson Surveyor L.C.

8163

April 3rd 1826

Survey No 19


Surveyed and divided sec. 23 in Range 14 Co. M. N.
 for William Davis and Robert Campbell beginning at the
 N.W. corner of Sec 23 original corner to sec. 22, 23, 28 & 29 a white oak
 14 inches in diam. W 76 E 22 links dist. a white oak 14 inches in diam.
 W 35 W 17 links dist. thence east between sec. 22 & 23 with the original
 line 16 1/2 poles to the quarter sec. corner
 a white oak 10 inches in diam. or 38 E
 24 links dist. continued with said
 line 16 1/2 poles further to the S.E. corner
 of said sec. & corner to sec. 16, 17, 22, & 23,
 a white oak corner tree thence north
 between sec. 17 & 23 162 poles, passed a ^{10 inches diam.} ~~Pyramid~~
 which is the original quarter section
 corner between sec. 17 & 23 324 poles to the corner of sec. 17, 18, 23 & 24
 a white oak 24 inches in diam. S 18 W 32 links dist. a white oak
 14 inches in diam. W 63 E 13 links dist. thence west between
 sec. 23 & 24, passed the quarter sec. corner between sec. 23 & 24 at
 16 1/2 poles a white oak 16 inches in diam. S 73 E 36 links dist. a white
 oak 14 inches in diam. S 76 W 17 links dist. 326 poles to the corner
 of sec. 23, 24, 29 & 30 a white oak 14 inches in diam. S 76 E 22 links
 dist. a white oak 14 inches in diam. S 35 W 17 links dist. return
 to the last named or sec. corner thence south 16 1/2 poles and struck up
 a stake in a wet prairie & continued 162 poles further to the first

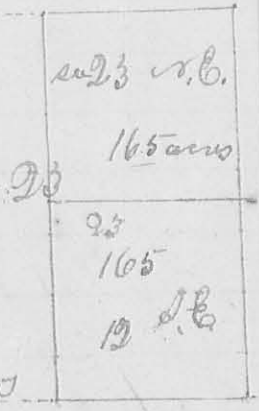

183
mentioned quarter sec. comes in the south line of the section
then returned to the stake in the prairie thence east 165 to
the east line of the sec. near the hickory formerly mentioned
place where another hickory ~~tree~~ 10 in diam. bears west 8 links
dist - The line from the stake in the prairie divides the east
half of said sec into 2 equal parts containing each 165 acres

James W. Harman, S. L. C.
April 4th 1823 Survey No. 13 (8164)

Surveyed at the request of Robert Casbolt
and William Davis beginning at the quarter section corner
between sections 17823 in Town 3 Range 12 E at a hick
-ory 10 inches in diam. west 8 links dist. Thence ~~west~~ north
between sec. 17823 with the original
line 40 poles to a stake in a prairie
thence $66\frac{1}{2}$ or 90 poles to a stake in
the same prairie and in the line
between the S.E. and N.E. quarters
of sec 23 in said Town and Range
thence east with said quarter section line 80 poles to the beginning
containing ten acres, a right angled triangle in the S.E. corner
of the north east quarter of said section

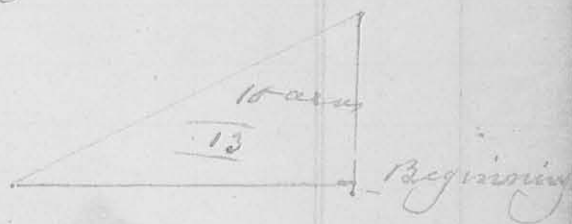

Ja. W. Harman Surveyor Logan Co.

April 4th 1823 Survey No. 14 (8164)

Surveyed 25 acres of land for William
Davis, who presented to me a certificate from me to
McColloch Auditor of Logan County, bearing date at
Bellefontaine March 10th 1823 certifying that there was
that day twenty five acres of land sold to William Davis
for the taxes interest and penalty for the years 1820, 1821
and 1822, entered for taxation in the name of Henry
Heifer in Range 14 Town 3 and Sec. 17 north west
quarter, to be laid off by metes and bounds, by line par
-allel with the lines of the tract, in as near a square
form as practicable; Whereupon I proceeded to, and laid