


183  
mentioned quarter sec. comes in the south line of the section  
then returned to the stake in the prairie thence east 165 to  
the east line of the sec. near the hickory formerly mentioned  
saw where another hickory ~~was~~ 10 in diam. bears west 8 links  
dist — The line from the stake in the prairie divides the east  
half of said sec into 2 equal parts containing each 165 acres

— — — — — James W. Eckman, S. L. C.  
April 4<sup>th</sup> 1823 Survey No. 13 (8164)

Surveyed at the request of Robert Casbolt  
and William Davis beginning at the quarter section corner  
between sections 17823 in Town 3 Range 12 E at a hick-  
-ory 10 inches in diam. west 8 links dist. Thence ~~west~~ north  
between sec. 17823 with the original  
line 40 poles to a stake in a prairie  
thence  $61\frac{1}{2}$  or 90 poles to a stake in  
the same prairie and in the line  
between the S.E. and N.E. quarters  
of sec 23 in said Town and Range  
thence east with said quarter section line 80 poles to the beginning  
containing ten acres, a right angled triangle in the S.E. corner  
of the north east quarter of said section

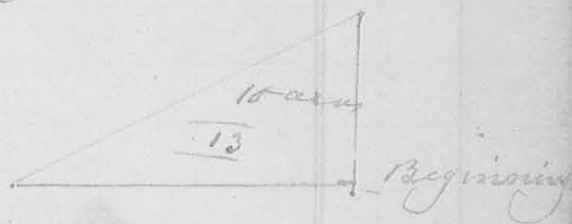

Ja. W. Eckman Surveyor Logan Co

April 4<sup>th</sup> 1823 Survey No. 14 (8164)

Surveyed 25 acres of land for William  
Davis, who presented to me a certificate from me to J.  
McColloch Auditor of Logan County, bearing date at  
Bellefontaine March 10<sup>th</sup> 1823 certifying that there was  
that day twenty five acres of land sold to William Davis  
for the taxes interest and penalty for the years 1820, 1821  
and 1822, entered for taxation in the name of Henry  
Heifer in Range 14 Town 3 and sec. 17 north west  
quarter, to be laid off by metes and bounds, by line par-  
-allel with the lines of the tract, in as near a square  
form as practicable; Whereupon I proceeded to, and laid

off twenty five acres in the north west corner of said section quarter section; Beginning at the corner between sec<sup>s</sup> 17, 18, 23 & 24 in said Town and Range original corner a white oak 24 inches in diam.

Beginning



thence  $S 88^{\circ} W$  33 links dist. a white oak 14 inches in diam.  $S 63^{\circ} E$  13 links dist thence east between sec<sup>s</sup> 17 & 18 with the original line  $6 \frac{3}{4}$  poles to a stake in a prairie where a bur oak 20 inches in diam. bears  $S 86^{\circ} E$  14 1/2 links dist. thence  $S 63^{\frac{1}{2}}$  poles to a dead white oak 24 inches in diam. corner tree thence west  $6 \frac{3}{4}$  poles to the line between sec<sup>s</sup> 17 & 23 a dead white oak 22 inches in diameter  $S 22^{\circ} W$  19 links dist. thence with said <sup>line</sup>  $6 \frac{3}{4}$  poles to the beginning containing 25 acres in a square form in said  $q$  sec as of record.

J. A. Wellman S. L. C.

April 28<sup>th</sup> 1826


(8169)

Survey No 15

Surveyed for Isaac Zane begin-

ning at an elm and blue ash on the bank of a small creek and in the vicinity of William Cochran's survey ex<sup>o</sup> 3437 thence  $S 80^{\circ} E$  10 1/4

Beginning

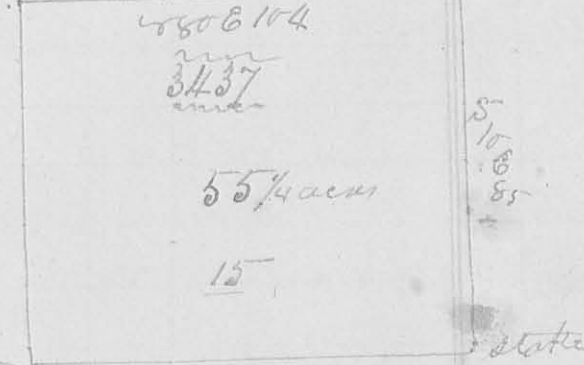

poles to a buck near the Sandusky road. thence  $S 10^{\circ} E$  85 poles to a stake on the west side of said road. thence  $S 80^{\circ} W$  10 poles to a small elm and sugar tree in the line above named

thence with said line  $S 10^{\circ} W$  85 poles to the beginning containing fifty five and one fourth acres part of Cochran's survey ex<sup>o</sup> 3437

Isaac Zane } Lt.  
John Zane }

James Wellman  
Surveyor of Floyd County