



Survey No 5243

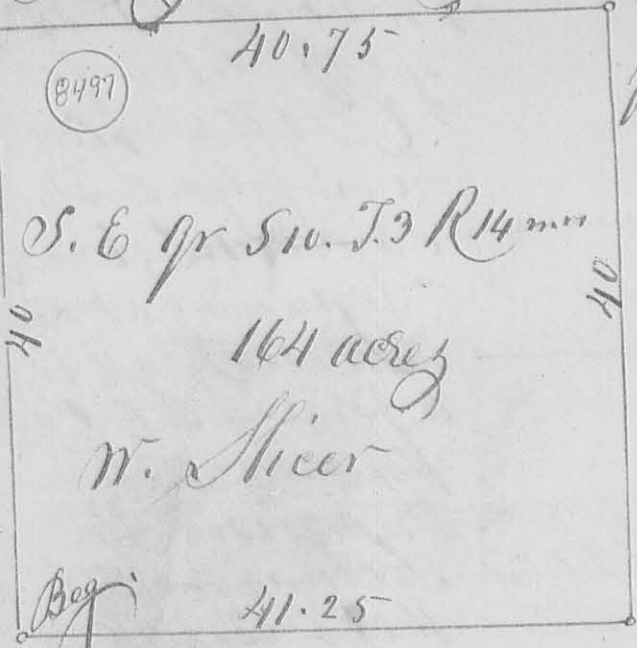

21

Surveyed April 11th 1844
 for R. Patterson Adm. of
 A. O. Spencer Dec. the
 S. E. quarter of Sec 10 Town
 3. Range 14 mrs as follows:
 Beginning at the S. E. corner
 of said qr sec. at a
 black 12 in diam. N 35° E
 12 links, a white Oak 18 in
 diam. S 56° W 46 links;
 thence N 88° W 41.25 ch.
 to a white oak 15 in diam
 S 40° E 12 links (the other tree
 is down) q. corner between sections 9 & 10; thence
 N 2° E 40 chains crossing a small branch to a Bar
 Oak 16 in diam. N 87° W 21 links, a white oak 16 in
 diam. S 75° E 71 links; thence S 88° E 40.75 ch.
 to a stone a white oak 8 in diam. S 18° W 43
 links a white oak 8 in diam. N 15° E 50 links
 thence with the east line of Sec 11 1/2 W 40 chains
 to the beginning containing
 164 acres.

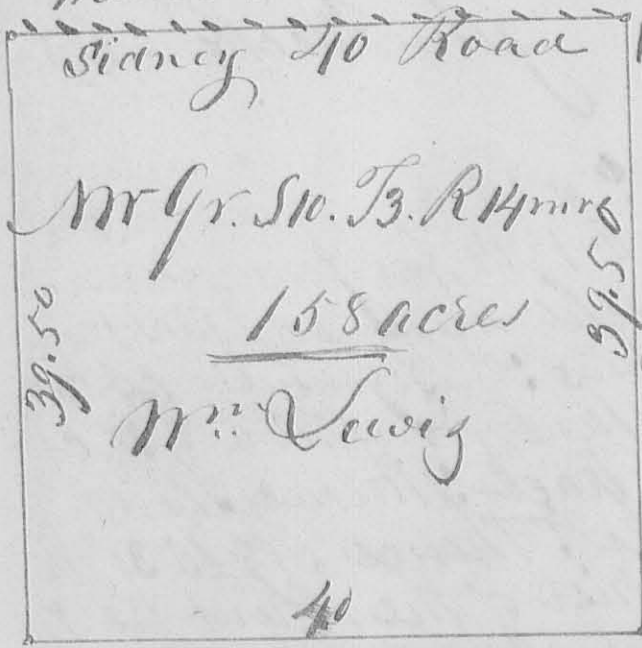

The NW qr of S10 T3 R14
 as follows: Beg. at the NW
 cor. of said sec. at a stone
 a Hickory 24 in D. S 9° E 24
 links a white oak 12 in D
 N 29° E 9 links distant
 both trees down; thence
 S 88° E 40 chain to a stone;
 thence S 2° W 39.50 ch. to a
 Bar Oak 16 in D N 82° W 2
 links, a white oak 16 in D. S 75° E 71 links centre
 corner; thence N 88° W 40 chain crossing a prairie
 to a stake in the prairie; thence N 2° E 39.50 chain to
 the beginning. Containing 158 acres
 Wm Mechem C.