



REC'D 3-3-97 smy

SCALE: 1" = 30'

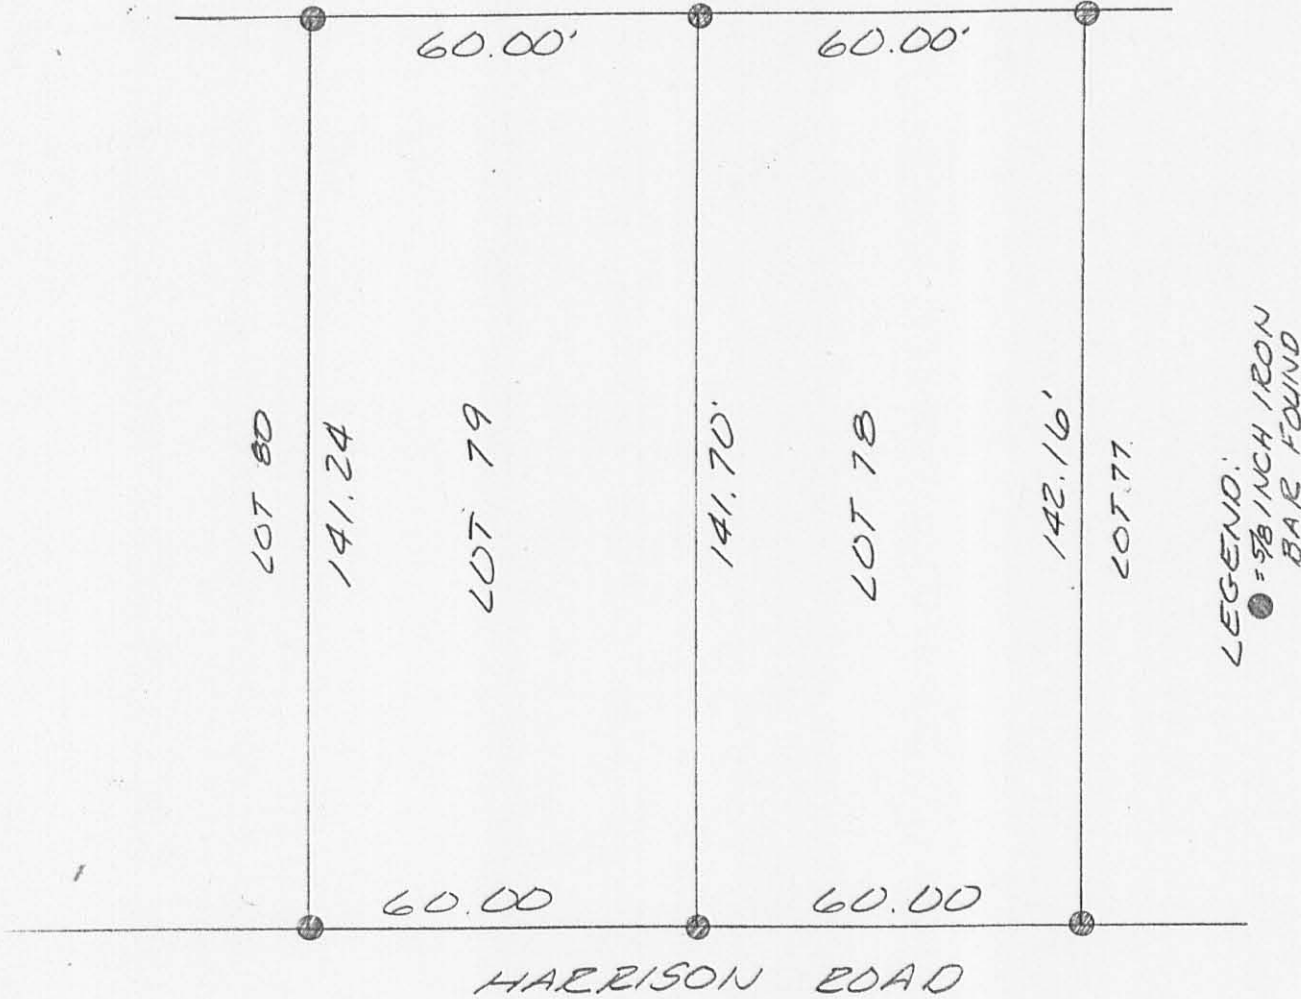

SURVEY OF LOTS 78 + 79 OF
OHIO VALLEY COURT IN
SECTION 7, TOWN 2, RANGE 15,
HARRISON TOWNSHIP, LOGAN
COUNTY, OHIO FOR MARLENE
NAPIER ON FEBRUARY 25, 1997

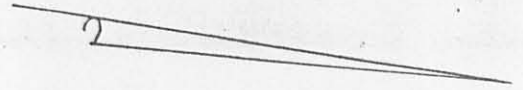

INDEXED ON MAP
8721 IP

Leslie H. Geeslin

LESLIE H. GEESLIN
RUSHSVLVANIA, O
(937) 468-2793

JLB

REC'D 3-29-07 SMJ/OK


HARRISON ROAD (50')

OHIO VALLEY COURT
PLAT CABINET A, SLIDE 527

LOT 40


LOT 41

LOT 42

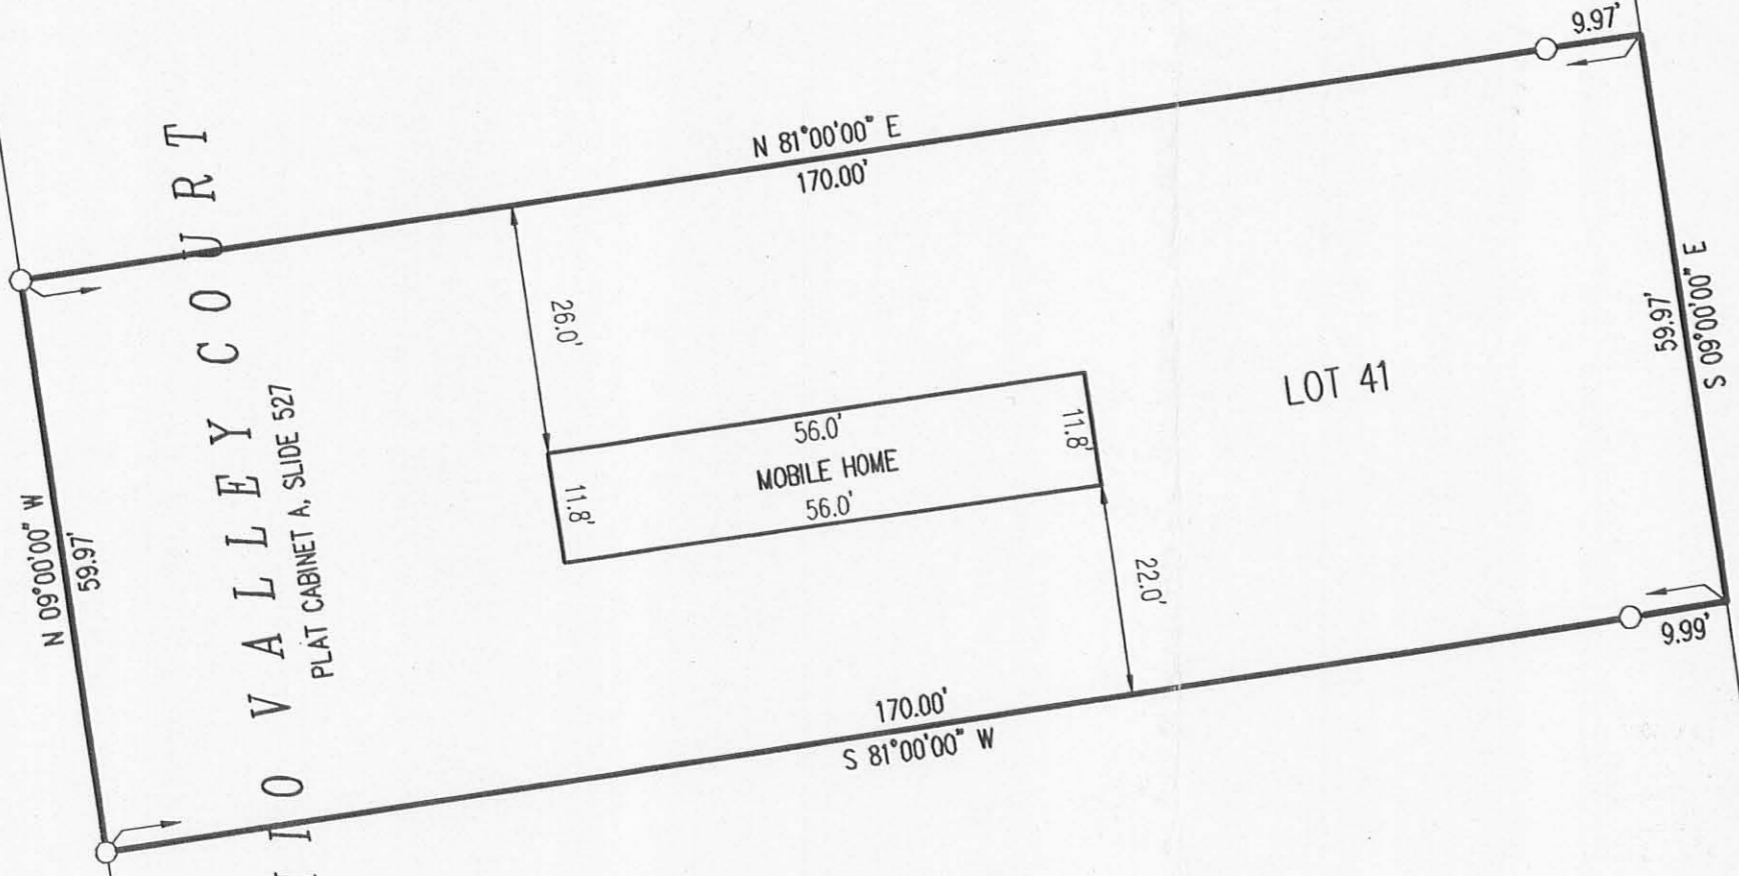

COUNTY HIGHWAY 130 (60')

S 09°00'00\" E
(BASIS FOR BEARINGS)

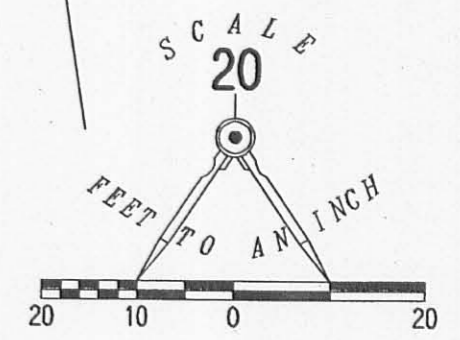

LEGEND:

○ 5/8 INCH IRON ROD FOUND

RETRACEMENT SURVEY OF THE
 CHARLIE JUNIOR BLANKENSHIP
 LOT 41
 OHIO VALLEY COURT
 PLAT CABINET A, SLIDE 527
 OFFICIAL RECORD 865, PAGE 893
 SECTION 7, TOWN 2, RANGE 15
 HARRISON TOWNSHIP
 LOGAN COUNTY, OHIO

SURVEYED BY:

William K. Bruce
 WILLIAM K. BRUCE
 PROFESSIONAL SURVEYOR 7437
 MARCH 25, 2007




ORIGINAL STAMP IN GREEN

COPYRIGHT 2007 BY:
 LEE SURVEYING & MAPPING CO., INC.
 117 North Madriver Street
 BELLEFONTAINE, OHIO 43311
 (937) 593-7335
 surveys@lsminc.us
 KSR D0307 4392037 L-4392-3

2 WORKING DAYS
BEFORE YOU DIG
 CALL TOLL FREE **800-362-2764**
 OHIO UTILITIES PROTECTION SERVICE.

INDEXED ON MAP
 8721 2P

D. YOUNKMAN
7.336 AC.
O.R. 9, Pg. 301

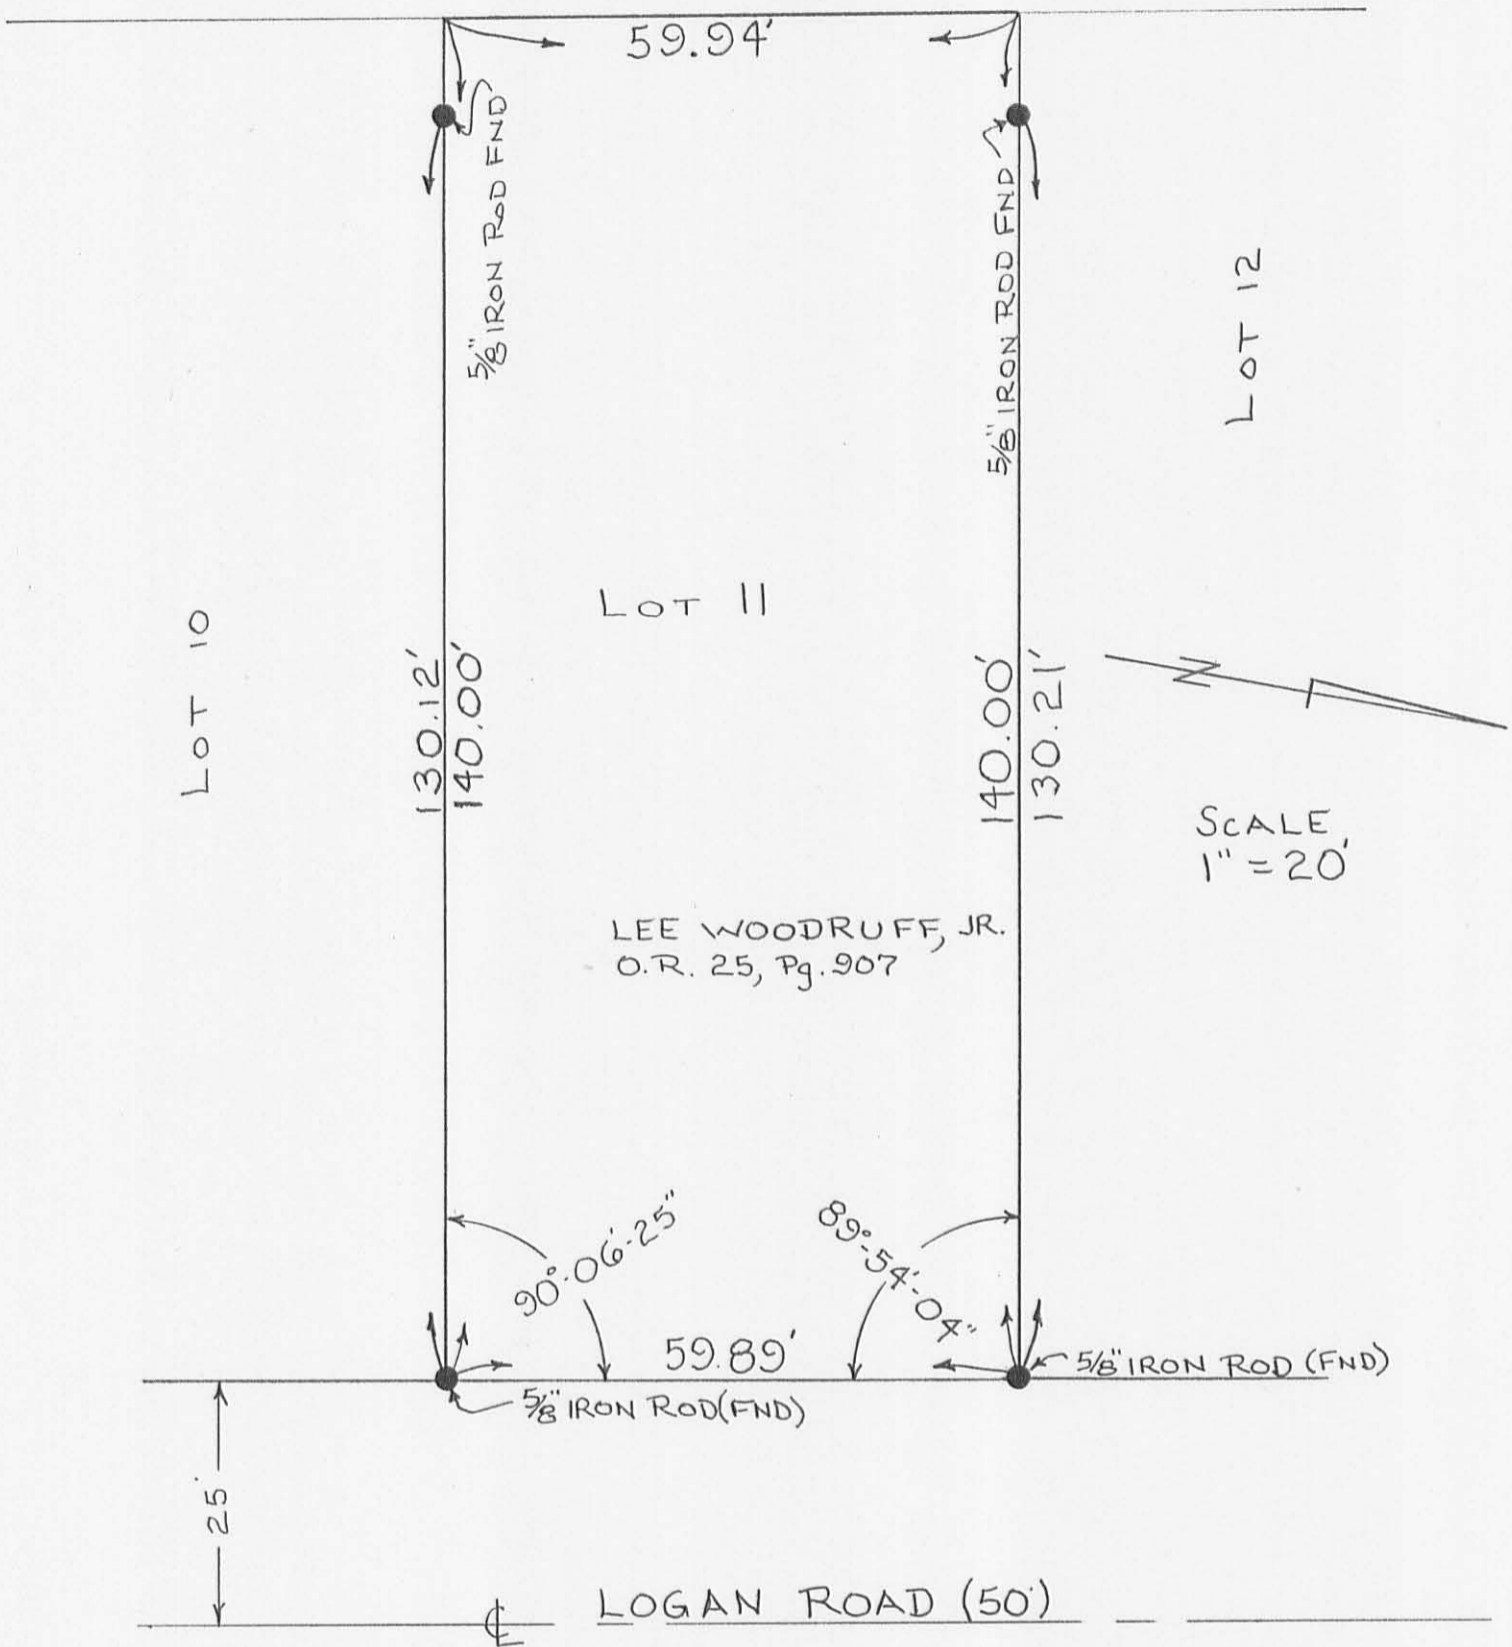

LEE WOODRUFF, JR.
O.R. 25, Pg. 907

SCALE
1" = 20'

RETRACEMENT SURVEY OF LOT II
OHIO VALLEY COURT
SEC. 7, T-2, R-15
HARRISON TWP.
LOGAN COUNTY, OHIO



ORIGINAL STAMP IN GREEN


INDEXED ON MAP
872/3P

By: *[Signature]*
JEFFREY I. LEE
PROF. SURVEYOR #6359
JULY 30, 1992

LEE SURVEYING & MAPPING CO.
143 East Columbus Avenue
BELLEFONTAINE, OHIO 43311
(513) 593-7335

L1163-4A

REC'D 1-23-12 SVM OK

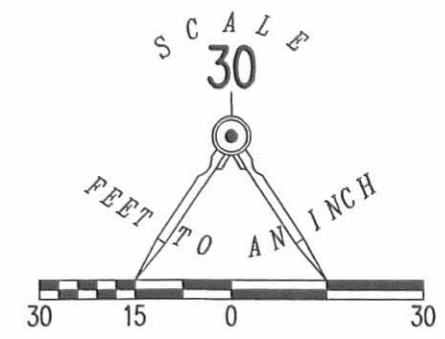


LEGEND:
 ○ 5/8 INCH IRON ROD FOUND

RETRACEMENT SURVEY OF
 LOT 33
 OHIO VALLEY COURT
 PLAT CABINET A, SLIDE 527
 SECTION 7, TOWN 2, RANGE 15
 HARRISON TOWNSHIP
 LOGAN COUNTY, OHIO

SURVEYED BY:
William K. Bruce

WILLIAM K. BRUCE
 PROFESSIONAL SURVEYOR 7437
 JANUARY 12, 2012

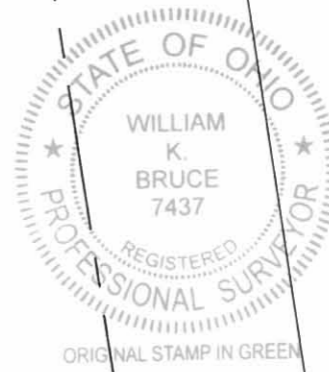

COPYRIGHT 2012 BY:
LEE SURVEYING & MAPPING CO., INC.
 117 North Madriver Street
 BELLEFONTAINE, OHIO 43311
 (937) 593-7335
 WWW.LSMINC.US
 surveys@lsminc.us

KSS D0112 52560112 L-5256-3

2 WORKING DAYS
BEFORE YOU DIG
 CALL TOLL FREE **800-362-2764**
 OHIO UTILITIES PROTECTION SERVICE.

INDEXED ON MAP
 8721 4P