


Road No. 129


(Cont'd.)

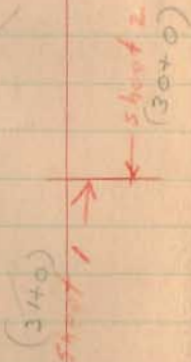

Party: Harold T.
D. Dodson
H. Keyser
E. Sprock

Jan 21, 1949
Cold

8

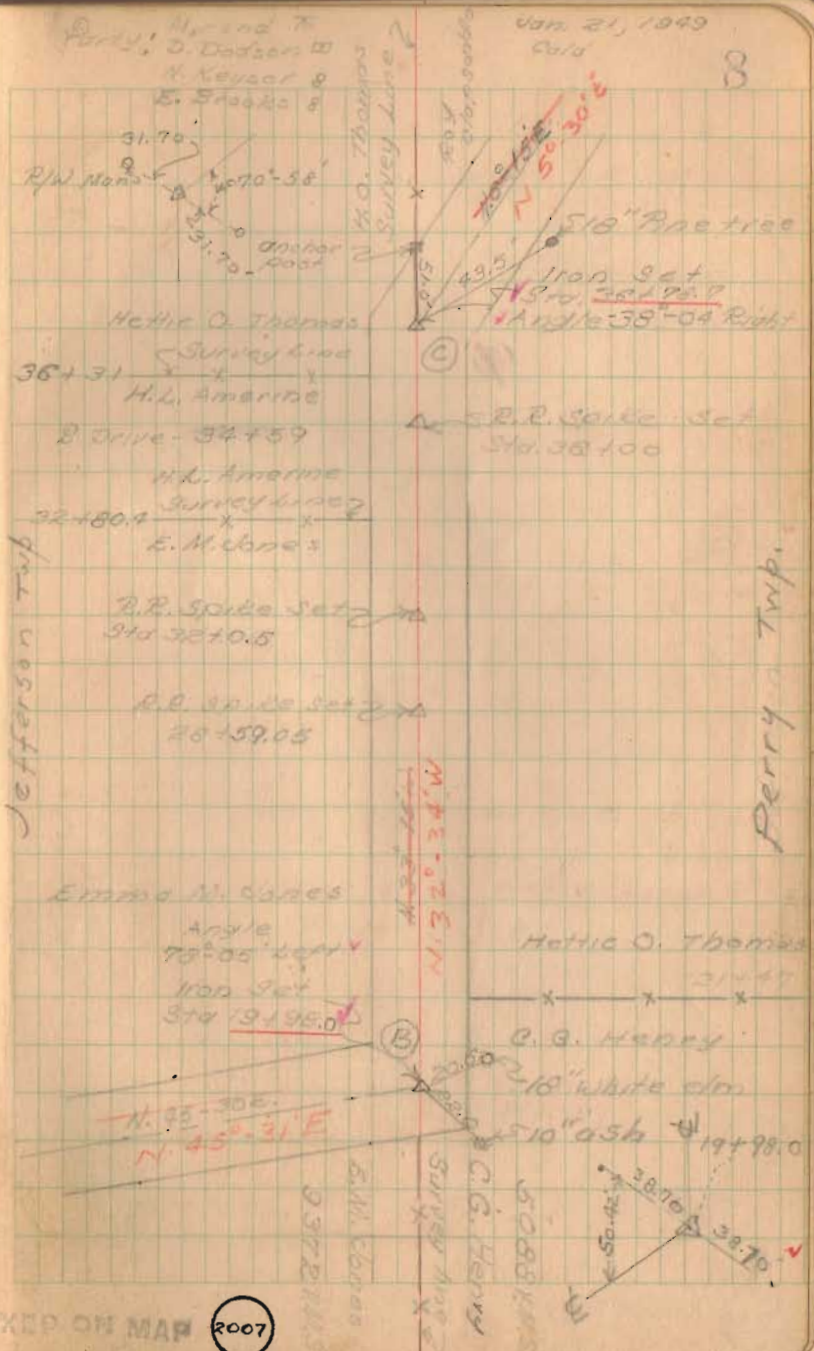

INDEXED ON MAP 2007

Road 129



Party: M. Hand
D. Dodson
N. Keyser

Jun. 25, 1949
Cold

9

N
↑

V.M.S. 2574

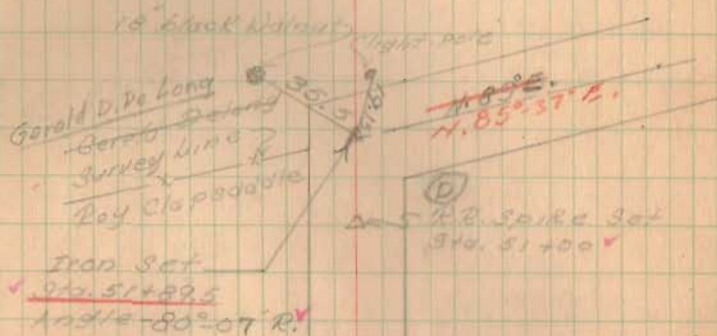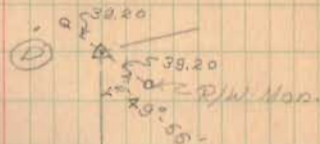

V.M.S. 5088

V.M.S. 5088

Roy Clapaddock

Roy Clapaddock
Herbie O. Thomas

N. 5° 30' E.

INDEXED ON MAP

2007

Rd # 129

Party: D. Dodson
D. Dodson
W. W. W. W.

Jan. 25, 1949
Cold 10

Roy Clapsaddle
K.M.S. 5091

~~N 4° 45' W~~
N 4° 45' W

K.M.S. 2674

12" stump

D.
Gerald, DeLong

Roy Clapsaddle



N 50° 15' E
N 50° 37' E

gate post

Iron Set

Sta. 50+82.1

Angle

90°-19' Left

100' fence post

R.R. Spike Set
Sta. 58+00

Sta. 59+96.2

75'

Sta. 59+61.2


75'

Two story frame house

INDEXED ON MAP

2007

Rd # 129

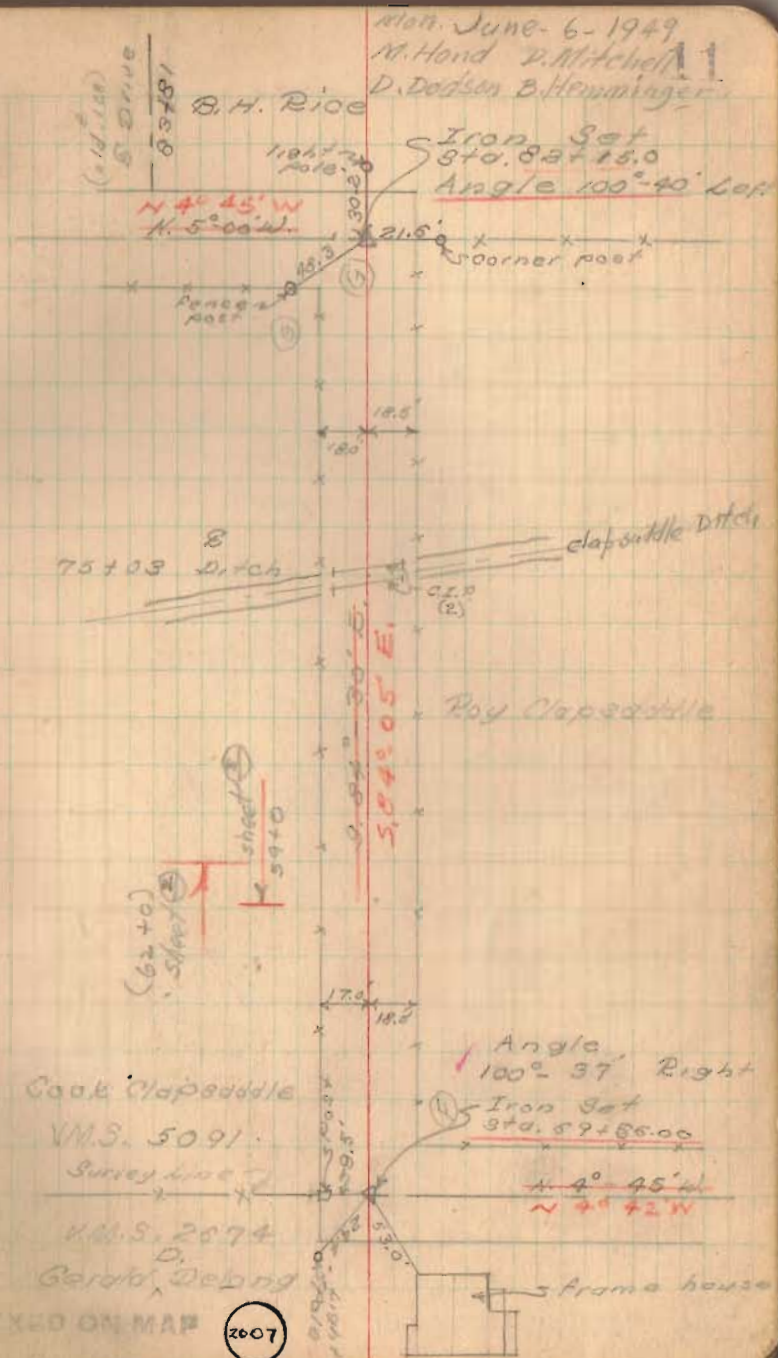


Rd # 120

Party - M. Hand
D. Mitchell
D. Dodson
B. Hemminger

6/7/49
Warm

12

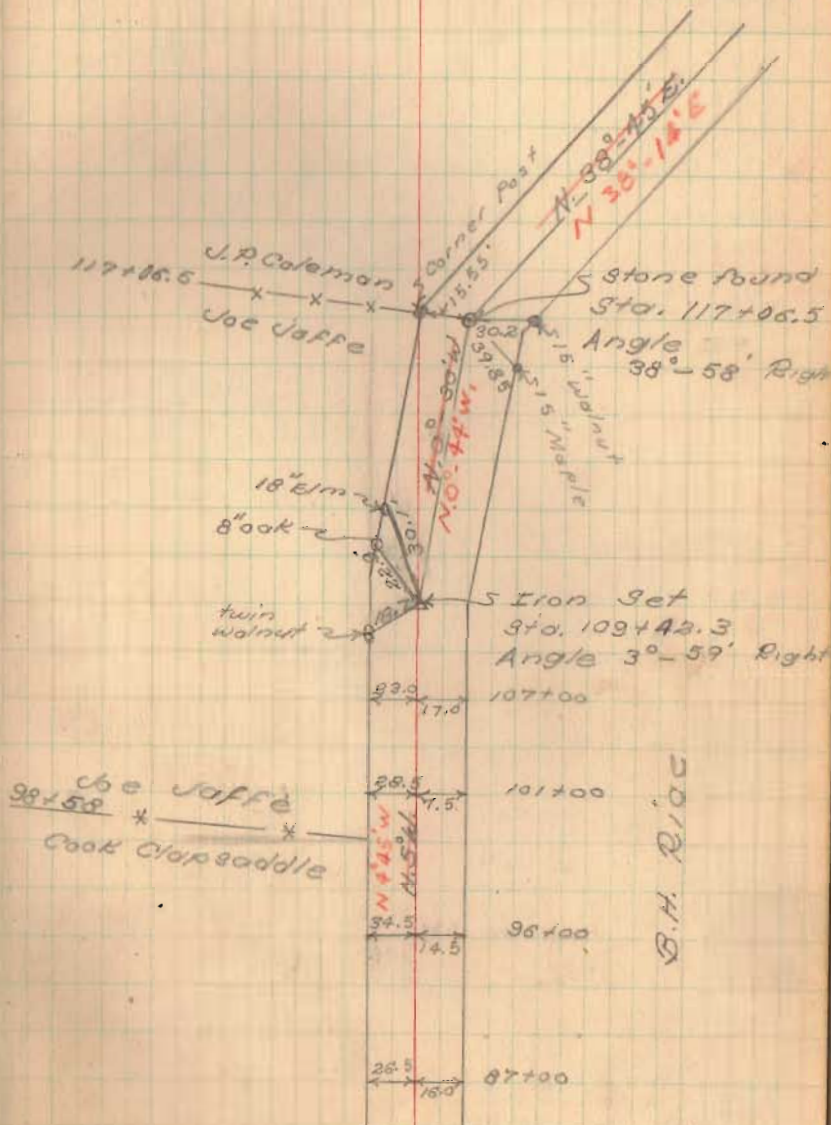


INDEXED ON MAP

2007

Rd. # 129

5/9/49
Warm 13

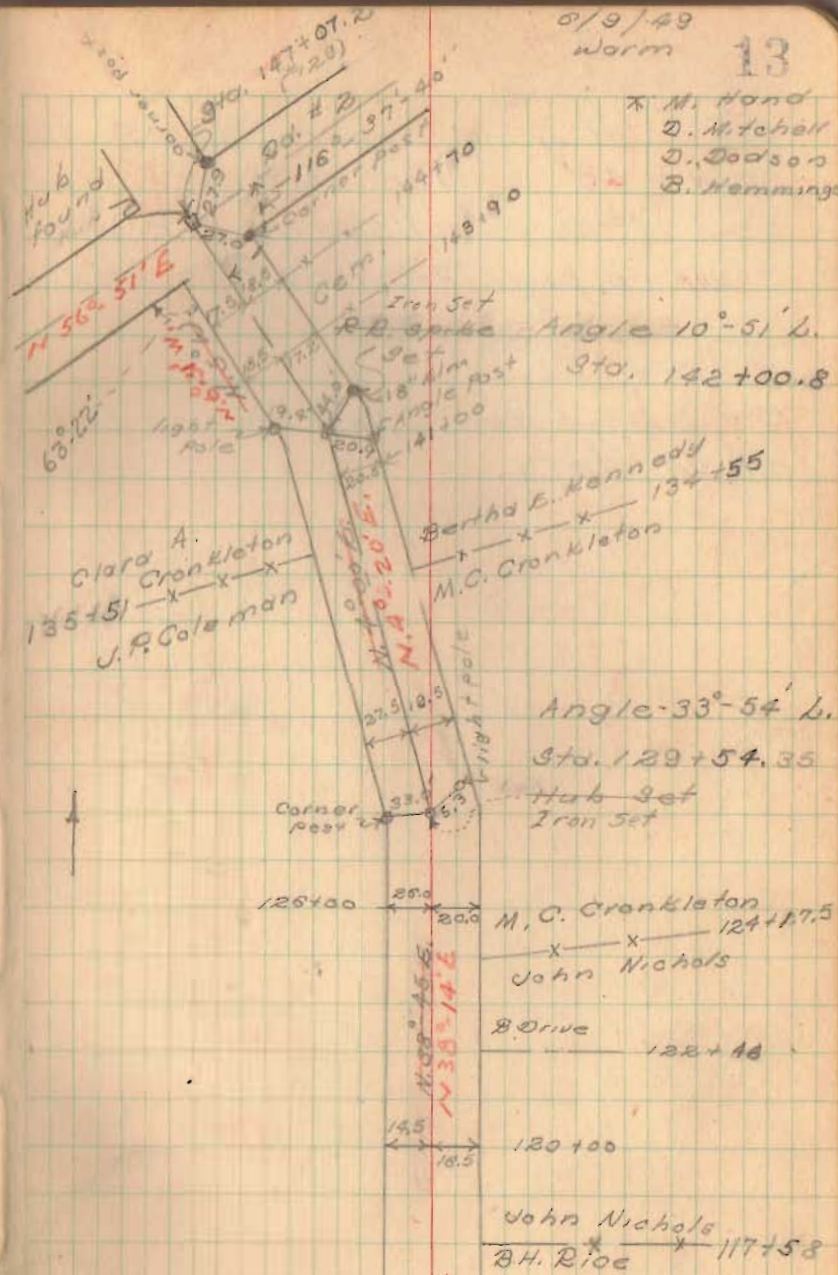

INDEXED ON MAP