


C. H. No. 218

MONROE TOWNSHIP

SURVEY FOR BR. 28-2.17

13+31.60 1" ϕ Bar Set on R

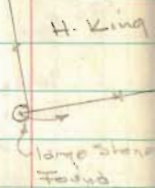


0+00 1" ϕ Bar Set Φ S.R. 287

See pg. 7 for detail of intersection

B. Dodson
E. Little
C. Nichols


March 9, 1968
400

5

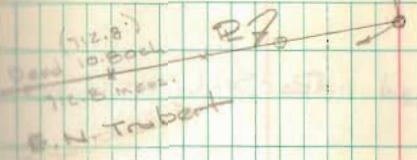

Sta 13+31.60
1" ϕ Bar Set
Angle: 2°04' Lt.
(4°07'40")

INDEXED ON MAP
9396

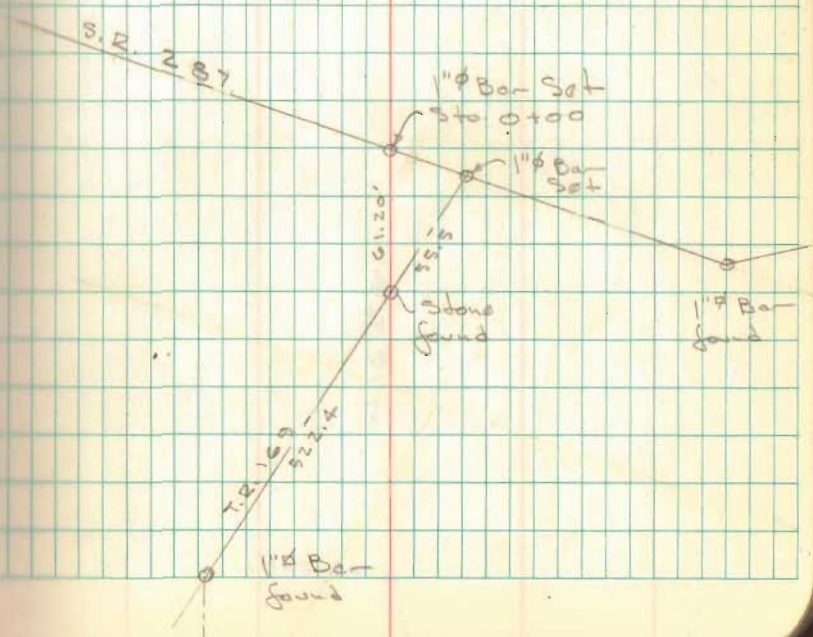

C.H. No. 28

22+07.57 R.D. Jpk. found R-Sol by F.F. Wright

Φ Revised from Jto. 13+31.60
to 24+39.35 June 17, 1968

See Pg. 37 this book

6

22+07.57




N 16 1/2° E.

13+31.60



DETAIL OF INTERSECTION
S.R. 287 - C.H. 28 - T.R. 169

- A = 1" ϕ Bar Found F.B. 702 pg. 67
 B = Stone w/t found 4 1/2' deep, placed
 1" ϕ bar over t @ surface
 C = 1" ϕ bar set \perp S.R. 287 on line "A-B" & "D"
 D = 1/2" ϕ bar found Sta. 176+24.7 F.B. 558/28
 E = 1" ϕ bar set \perp C.H. 28 & S.R. 287 on
 line between "B" and 1" ϕ bar @ Sta. 13+31.60
 and on line "D-F"
 F = 1" ϕ Bar found Sta. 177+71 F.B. 558/28

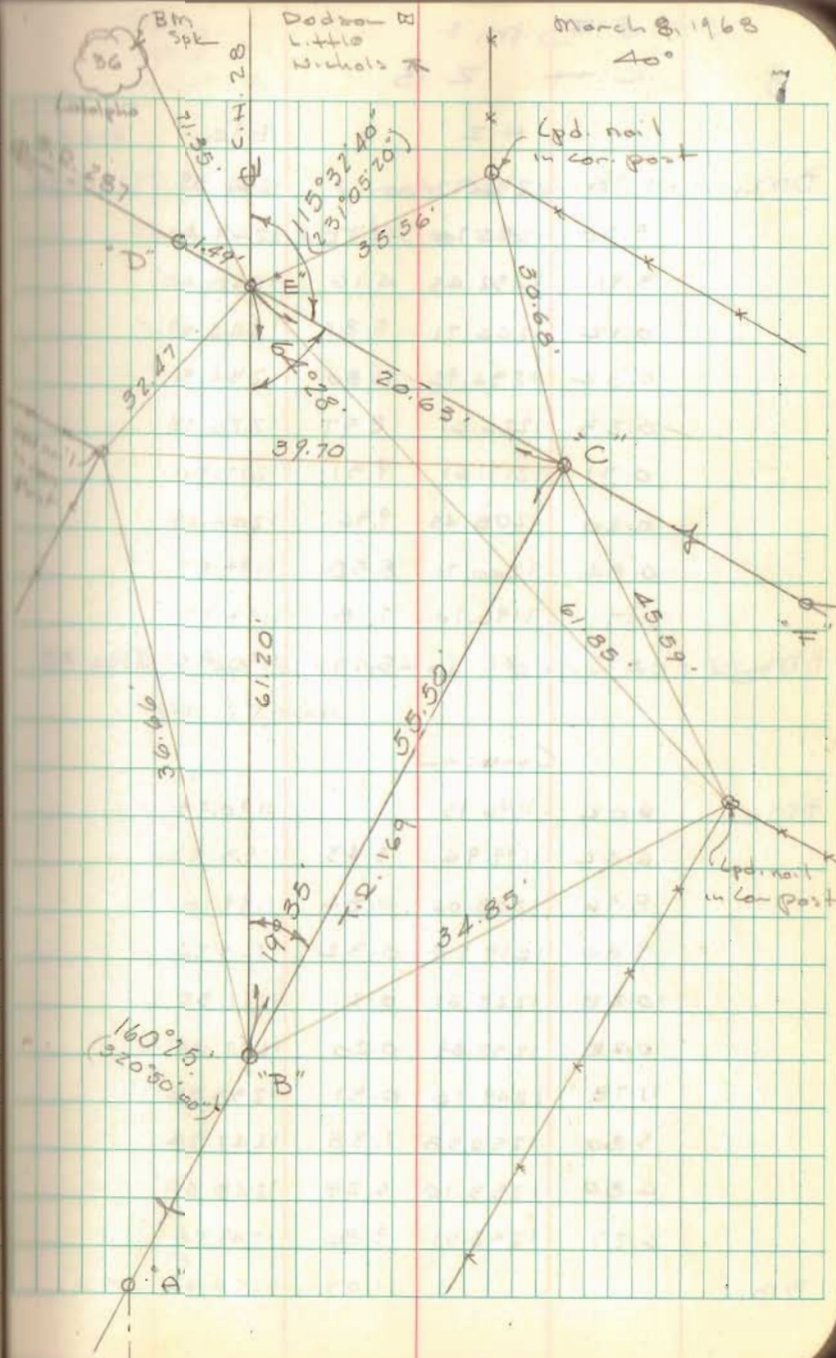


SURVEY OF C.H. No. 28
MONROE-JEFFERSON TWP.

- 25+00 R.R. Spk Set
 24+39.35 $\frac{3}{4}$ " ϕ Bar Found F.B. 518 pg. 66
 Angle $17^{\circ}33'40''$ RT. ($35^{\circ}07'00''$)
 23+90.2 R.R. Spk. Found 1.0' E. of ϕ (F.F.W.)
 22+07.6 R.R. Spk Found "
 13+31.60 1" ϕ Bar Set on Property line, see
 pg. 5 Angle $1^{\circ}41'00''$ Lt. ($3^{\circ}22'20''$)
 0+00 1" ϕ Bar Set ϕ S.R. 287
 See pg. 5-7 this book

C. Nichols
 J. Buchenroth
 M. Thompson
 S. Henry

June 17, 1968
 60° 37'

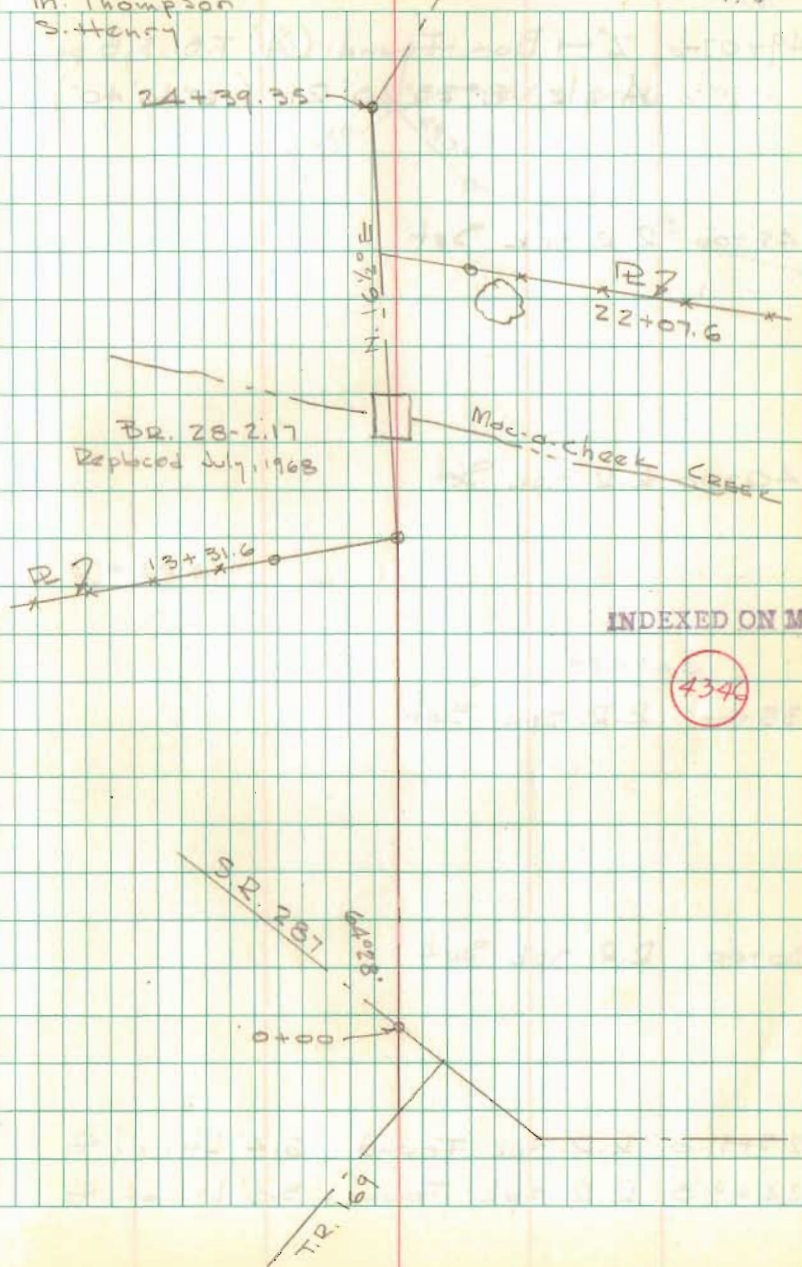

C.H. No. 28

49+07.6 2" H Bar Found (A" F.B. 5.8 pg. 66)

Angle $8^{\circ}23'20''$ RT. ($16^{\circ}46'40''$)

45+00 R.R. Spk Set

40+00 R.R. Spk Set

35+00 R.R. Spk Set


30+00 R.R. Spk Set

25+91.0 R.R. Spk Found 6.4' Lt. of C

24+91.3 R.R. Spk Found 3.0' Lt. of C

June 17, 1968

18

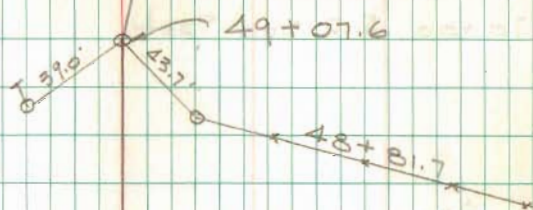

C.H. No. 28

91+38.64 old Hub Found 2.3' Rt. of C

88+30.58 $\frac{5}{8}$ " ϕ Bar Found
Angle $0^{\circ}27'00''$ LT ($0^{\circ}54'00''$)

85+00 R.R. Spk Set

80+00 R.R. Spk Set

75+00 R.R. Spk Set

Nichols
Bucheroth
Thompson
Henry

June 18, 1968


78° 40'

T.R. 164
88+30.58

x x x
85+09.9

x x x x
73+08.4

old Fence
74+50

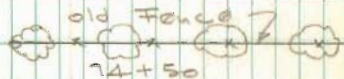

C.H. No. 28

110+00 R.R. Spk. Set


105+00 R.R. Spk. Set

100+00 R.R. Spk. Set

95+00 R.R. Spk. Set

June 19, 1968
80°

41

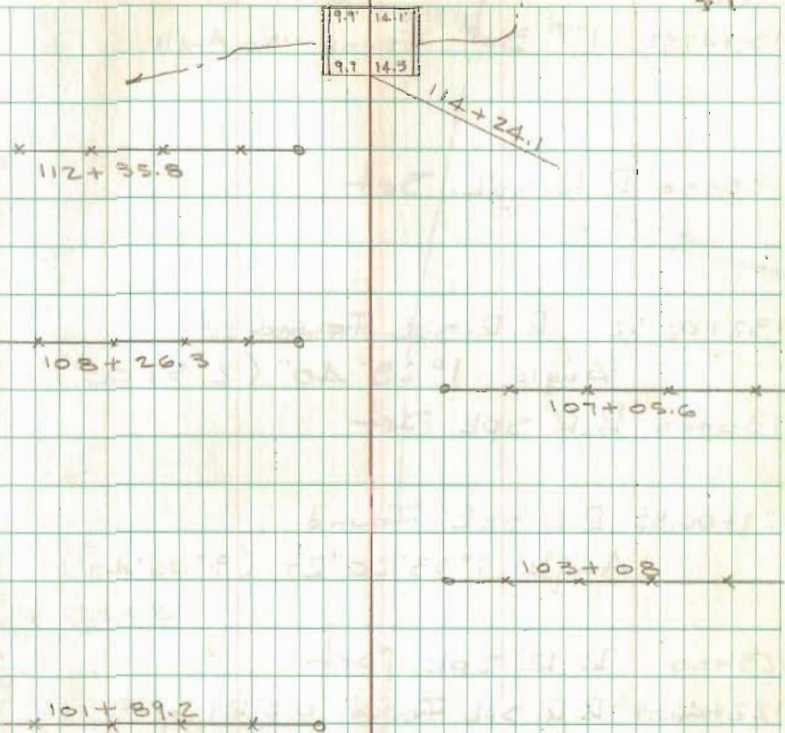

C.H. No. 28

139+47.95 1" ϕ Bar Found - No Angle

135+00 R.R. γ pk. Set

132+06.52 R.R. γ pk Found
Angle $1^{\circ}28'40''$ ($2^{\circ}57'00''$)

130+00 R.R. γ pk. Set

127+06.87 R.R. γ pk. Found
Angle $1^{\circ}33'20''$ RT. ($3^{\circ}06'40''$)

125+00 R.R. γ pk. Set

122+46.09 R.R. γ pk Found 0.3' RT. of ϕ

122+07.64 $\frac{3}{8} \times 1$ " Iron Found "I" bent
Angle $0^{\circ}54'40''$ RT. ($1^{\circ}49'20''$)

121+02.41 $\frac{5}{8} \times 2$ " Iron Found "I" bent


120+00 R.R. γ pk. Set

119+16.24 R.R. γ pk Found - No Angle

115+28.49 1" ϕ Bar Found - SURVEY LINE
Angle $1^{\circ}46'20''$ LT. ($3^{\circ}32'40''$)

115+00 R.R. γ pk Set

June 20, 1968
75° 42

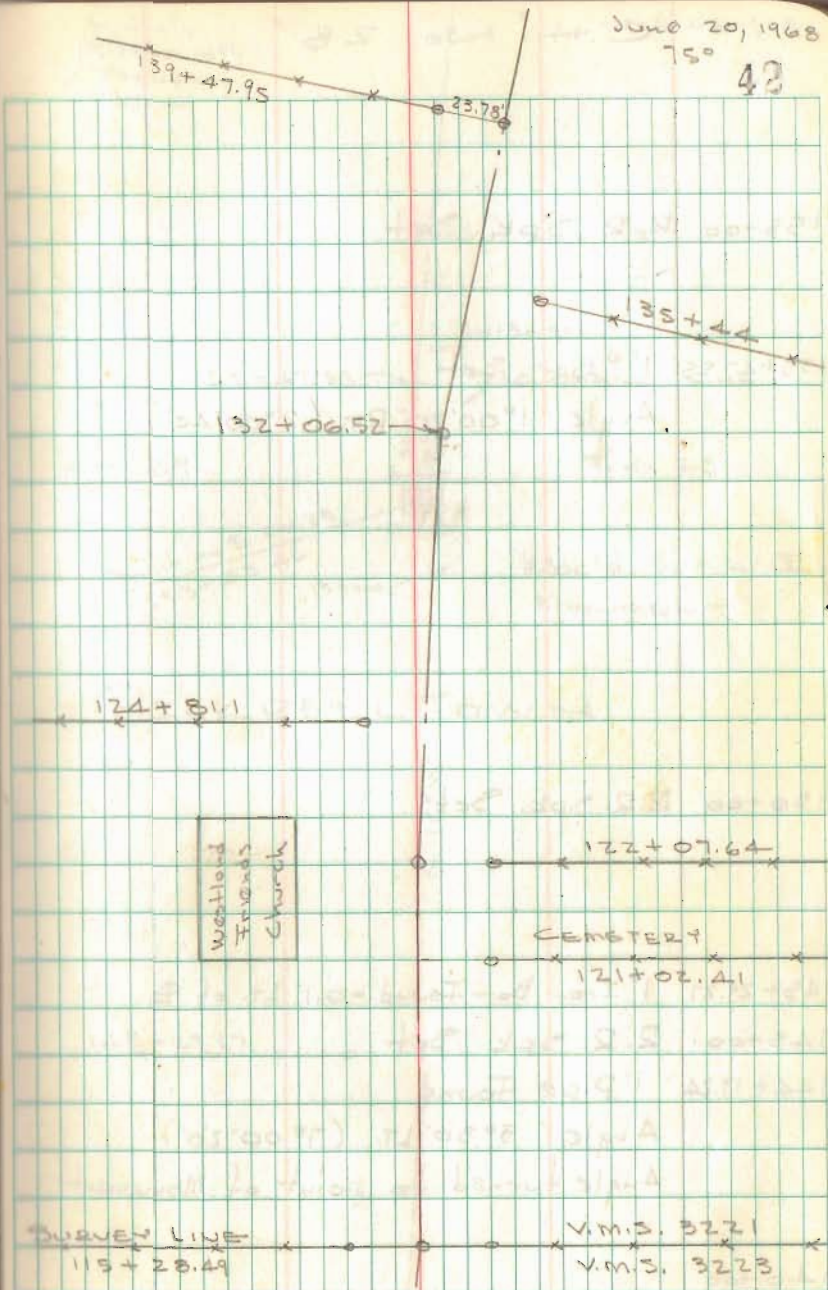

C.H. No. 28

155+00 R.R. Spk. Set

153+47.55 1" Bar Set

Angle $1^{\circ}00'20''$ RT. ($2^{\circ}00'40''$)

150+00 R.R. Spk. Set

145+29.27 1" Iron Bar Found - 0.1' Lt. of Φ

145+00 R.R. Spk. Set

144+17.24 1" Pipe Found

Angle $3^{\circ}30'$ LT. ($7^{\circ}00'20''$)


Angle turned to point of Monument

140+00

Nichols
Bochenroth
Thompson
Henry

June 20, 1968

43

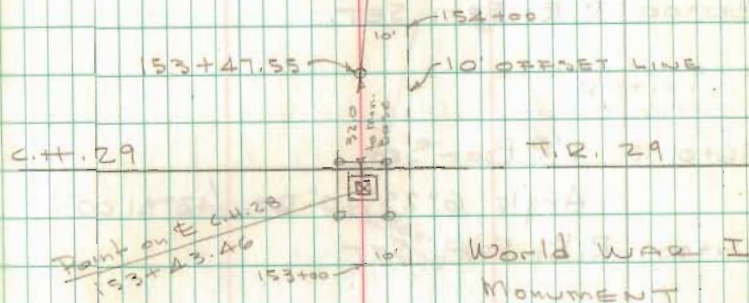

PICKRELL TOWN

145+29.27

JUNE 24, 1968

04

181+69.40 1" ϕ Bar Set

Angle $5^{\circ}03'20''$ LT. ($10^{\circ}06'40''$)

180+00 R.R. SPK. SET.

176+01.72 1" ϕ Bar Set


Angle $6^{\circ}25'40''$ RT. ($12^{\circ}51'00''$)

175+00 R.R. SPK. SET

170+00 R.R. SPK SET

165+00 R.R. SPK. SET

160+00 R.R. SPK. SET

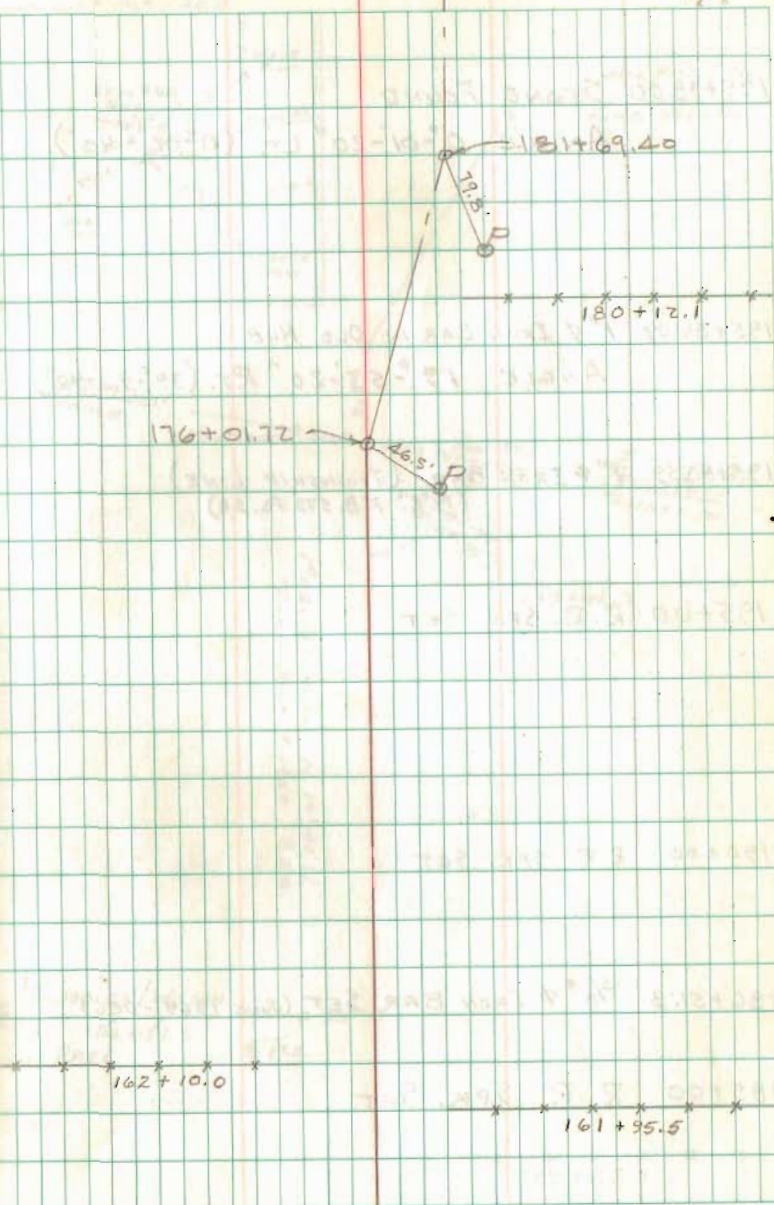

199+98.00 STONE FOUND
ANGLE $0^{\circ}01'20''$ LT. ($0^{\circ}02'40''$)

195+84.09 1" ϕ IRON BAR IN OLD HUB
ANGLE $19^{\circ}53'20''$ RT. ($39^{\circ}46'40''$)

195+80.59 1" ϕ IRON BAR (TOWNSHIP LINE)
(P.A. F.B. 573 Pg. 58)

195+00 R.R. SPK. SET

190+00 R.R. SPK. SET


186+51.3 $\frac{5}{8}$ " ϕ IRON BAR SET (JUNE 1969 - DEG)

185+00 R.R. SPK. SET

NOTE:
WITNESSES TO STONE
STA. 199+98.00
TAKEN JUNE 7, 1969 - DEG

JUNE 24, 1968

15

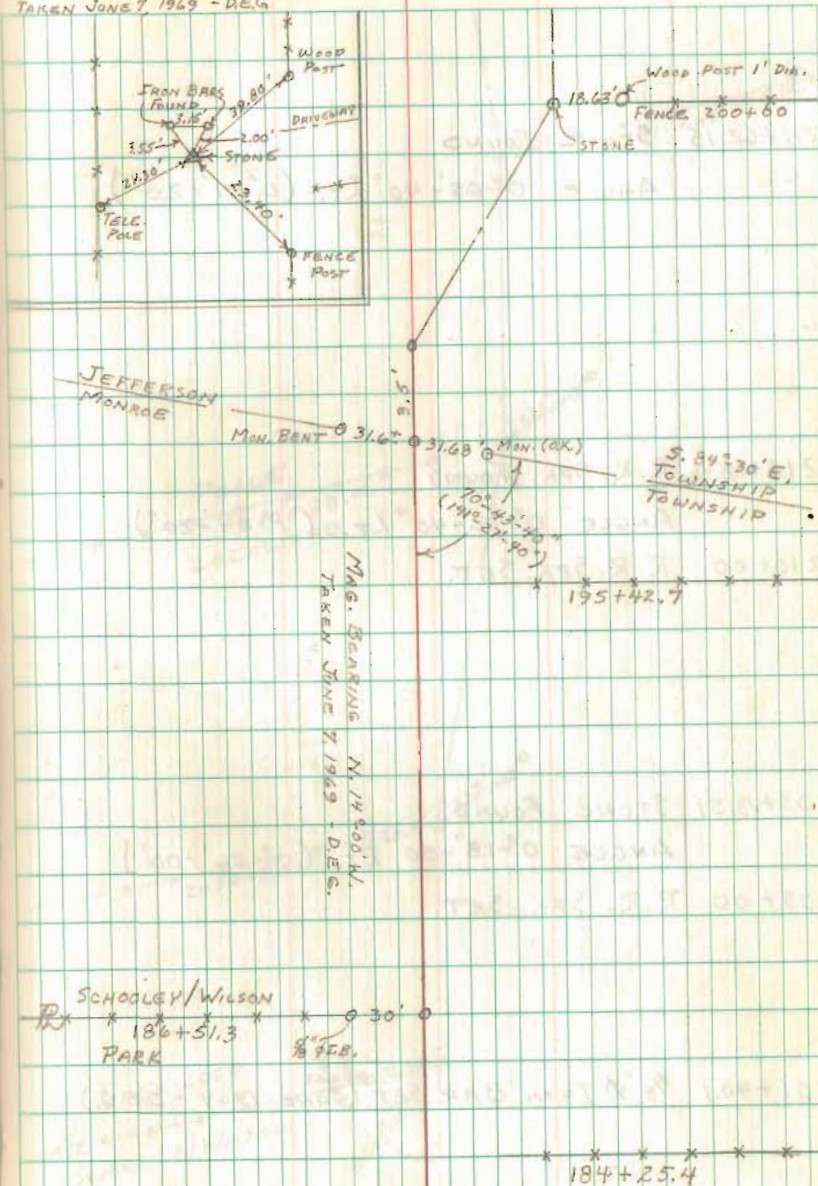

JUNE 25, 1968

46

211+62.15 STONE FOUND

ANGLE $0^{\circ}05'40''$ LT. ($0^{\circ}11'20''$)

210+28.16 R.R. SPK. FOUND

ANGLE $0^{\circ}32'40''$ LT. ($1^{\circ}04'20''$)


210+00 R.R. SPK. SET.

205+13.51 STONE FOUND

ANGLE $0^{\circ}18'00''$ RT. ($0^{\circ}36'00''$)

205+00 R.R. SPK. SET.

201+40.1 $\frac{5}{8}$ " ϕ IRON BAR SET (JUNE 1969 - D.E.G.)

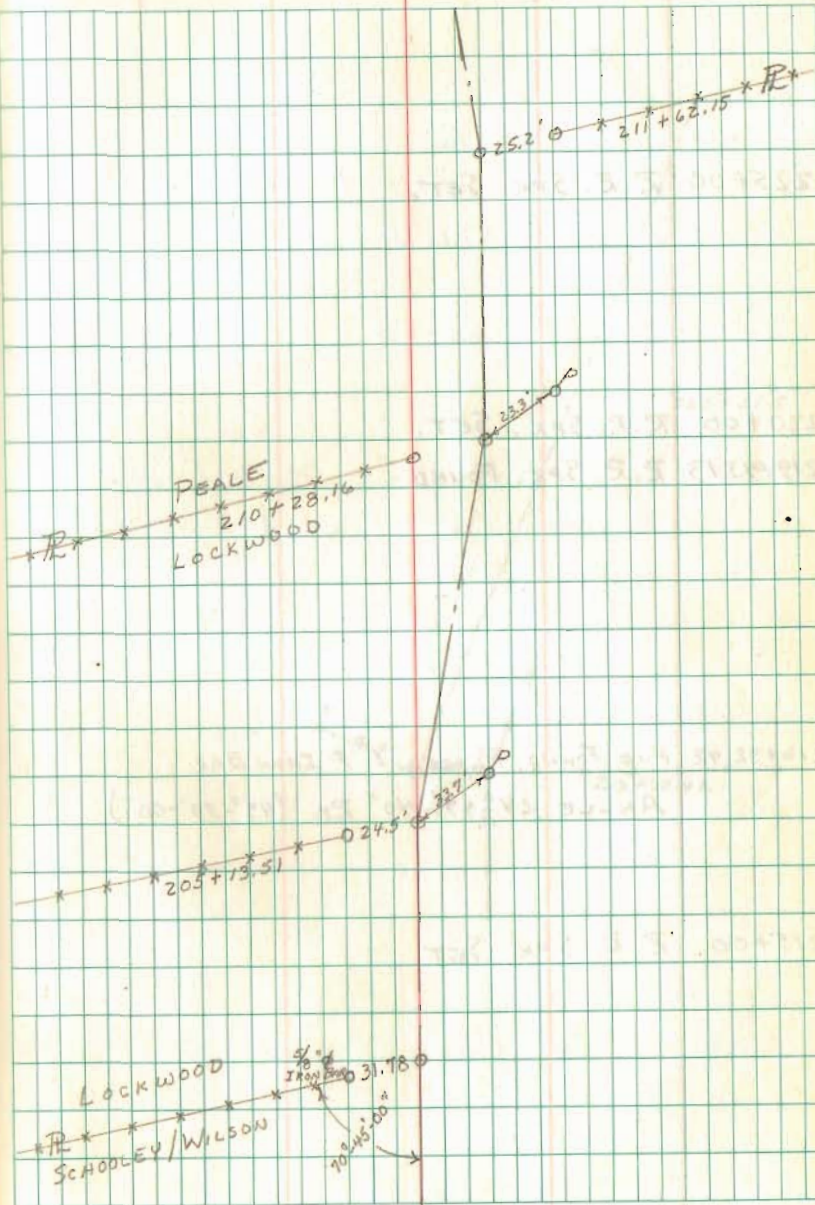


225+00 R.R. SPK. SET.

220+00 R.R. SPK. SET.

219+43.13 R.R. SPK. FOUND

216+92.42 HUB FOUND, PLACED 1" ϕ IRON BAR
ANGLE $24^{\circ}49'40''$ RT. ($49^{\circ}39'00''$)

215+00 R.R. SPK. SET

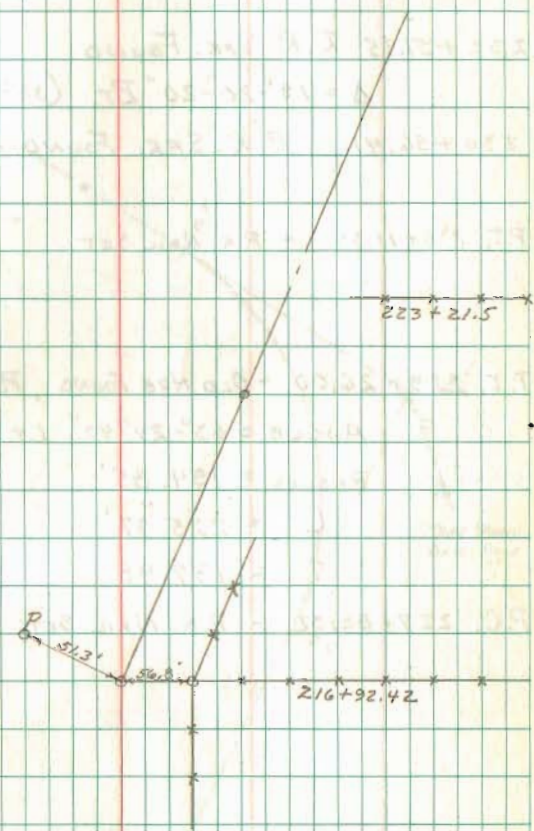

232+51.35 R.R. SPK. FOUND

$\Delta = 19^{\circ}-20'-20''$ RT. ($38^{\circ}-41'-00''$)

230+56.41 R.R. SPK. FOUND ON E

P.T. 230+13.39 - P.K. NAIL SET.

P.I. 229+26.00 - OLD HUB FOUND, PLACED 1" ϕ IRON BAR

ANGLE = $83^{\circ}-24'-40''$ LT. ($166^{\circ}-49'-20''$)

RADIUS = 154.85'

L = 225.37'

T = 137.98'


P.C. 227+88.02 - P.K. NAIL SET

225+58.45 R.R. SPK. FOUND

ANGLE $12^{\circ}-49'-20''$ RT. ($25^{\circ}-38'-40''$)

JUNE 25, 1968

48

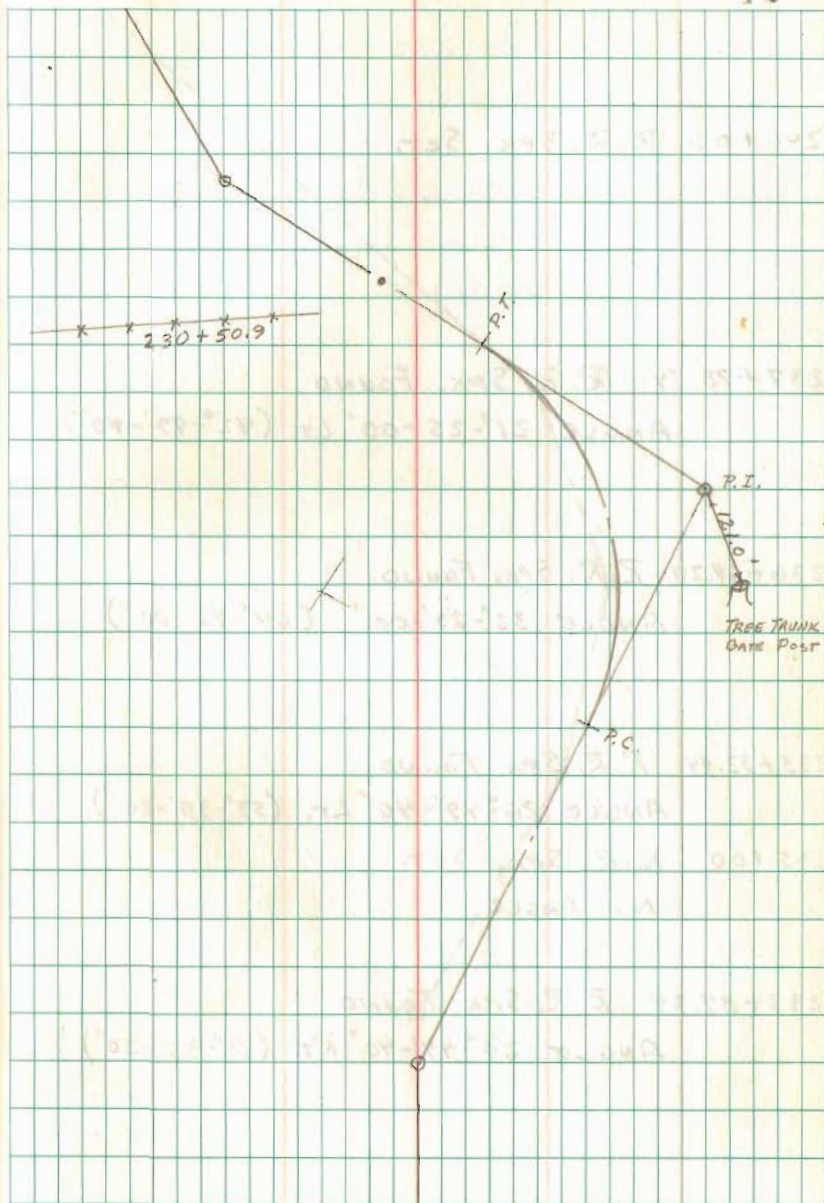

JUNE 25, 1968

49

240+00 R.R. SPK. SET,

237+78.54 R.R. SPK. FOUND

ANGLE $21^{\circ}-25'-00''$ LT. ($42^{\circ}-49'-40''$)

236+64.20 R.R. SPK. FOUND

ANGLE $32^{\circ}-23'-00''$ ($64^{\circ}-46'-00''$)

235+32.44 R.R. SPK. FOUND


ANGLE $26^{\circ}-49'-40''$ LT. ($53^{\circ}-39'-20''$)

235+00 R.R. SPK. SET,

NO ANGLE

233+87.34 R.R. SPK. FOUND

ANGLE $20^{\circ}-47'-40''$ RT. ($41^{\circ}-35'-20''$)

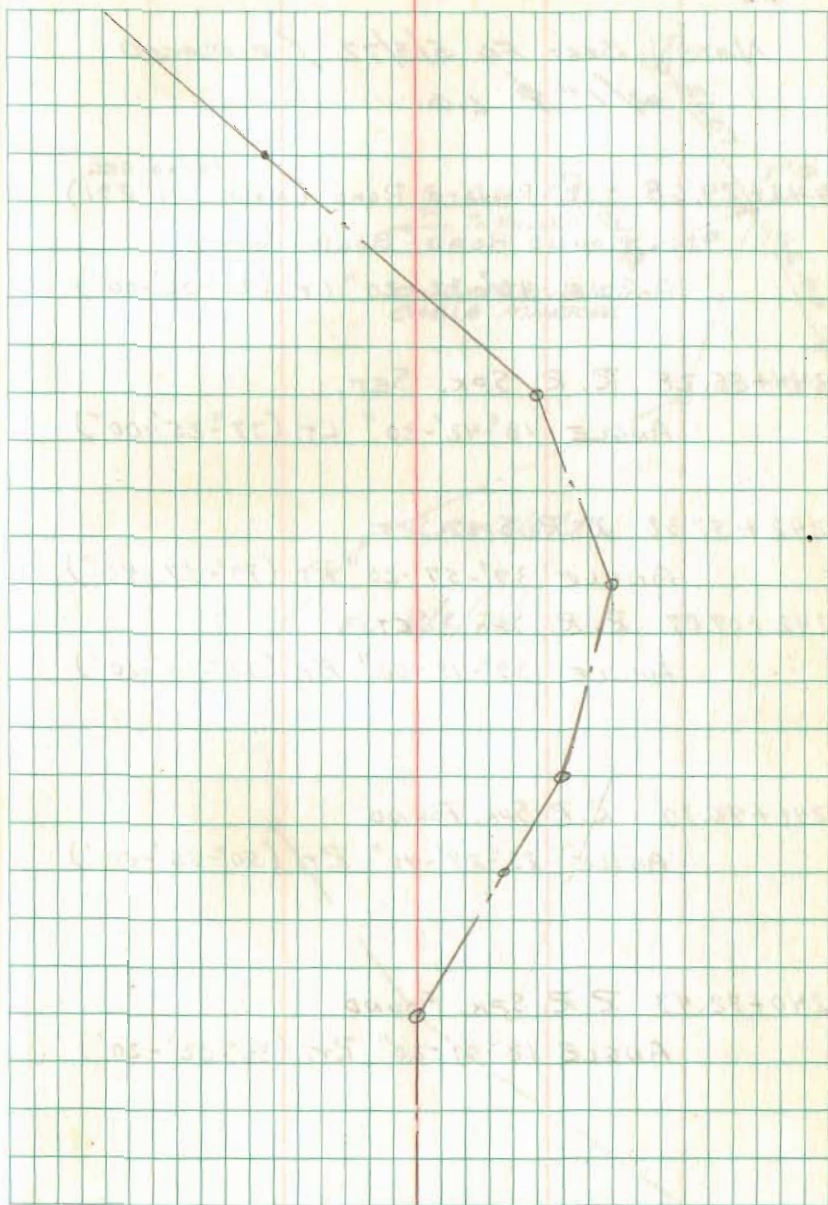

NOTE: BOLT FD 5/3/72 & REPLACED
w/ 1" ϕ L.G.

245+29.68 - E PRIVATE ROAD (Now C.H. 291)

8/6/69 DEG
ROUND HEAD BOLT FOUND

ANGLE $10^{\circ}-32'-20''$ LT. ($21^{\circ}-05'-00''$)

244+55.28 R.R. SPK. SET.

ANGLE $18^{\circ}-42'-20''$ LT. ($37^{\circ}-25'-00''$)

242+57.38 R.R. SPK. SET

ANGLE $39^{\circ}-57'-20''$ RT. ($79^{\circ}-54'-40''$)

242+07.87 R.R. SPK. SET.

ANGLE $39^{\circ}-15'-00''$ RT. ($78^{\circ}-30'-20''$)

241+46.30 R.R. SPK. FOUND


ANGLE $25^{\circ}-27'-40''$ RT. ($50^{\circ}-55'-00''$)

240+72.43 R.R. SPK. FOUND

ANGLE $18^{\circ}-01'-20''$ RT. ($36^{\circ}-02'-20''$)

JUNE 25, 1968

50

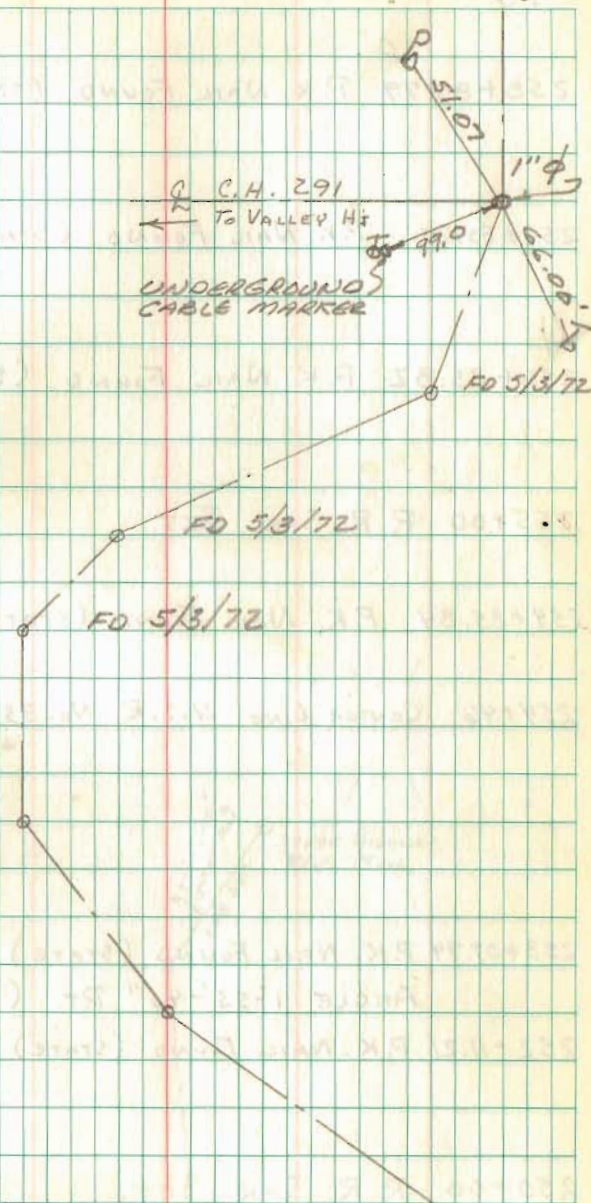

JUNE 28, 1969

51

258+85.79 P.K. NAIL FOUND (STATE)

257+85.79 P.K. NAIL FOUND (STATE)

256+85.82 P.K. NAIL FOUND (STATE)

255+00 R.R. SPK. SET.

254+85.84 P.K. NAIL FOUND (STATE)

254+46 CENTER LINE U.S.R. No. 33


253+07.94 P.K. NAIL FOUND (STATE)

ANGLE $1^{\circ}55'40''$ RT. ($3^{\circ}51'00''$)

252+11.21 P.K. NAIL FOUND (STATE)

250+00 R.R. SPK. SET.

U.S.R. 33
254+46

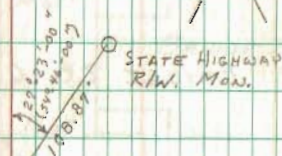

JUNE 26, 1968

52

TOTAL DIS. = 26,472.82' = 5.014 MILES

END STA.

264+72.82 P.K. NAIL SET ON APPARENT \mathcal{L}
OF C.H. 153


260+00 R.R. SPK. SET.

259+56.62 BRIDGE 28-6.76 (1965)

259+22.26 $\frac{1}{2}$ " ϕ IRON BAR FOUND
0.05' RIGHT OF \mathcal{L} .

C.H. 153

(OLD U.S.R. 33)

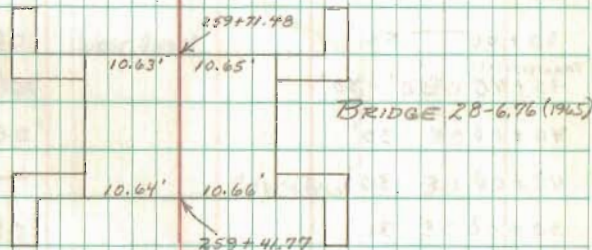

RIGHT OF WAY - C.H. 28

STA.	To.	STA.	WIDTH
0+00		22+40	60'
22+40		35+40	100'
35+40		235+45	60'
235+45		255+45	100'
255+45		264+72.82	60'

RIGHT OF WAY Mon's SET

STA.	LEFT	RIGHT
5+00	30'	30'
10+00	30'	30'
15+00	30'	30'
22+40	(ONLY 1 SET 50' WEST R/W. EAST IN FILL - KENNEDY SAND GRAUGL)	W. 30' R/W LARGE STONE IN PLACE
25+00	50'	50'
30+00	50'	50'
TRANSITION 35+40	50' - 30'	30' - 50'
40+00	30'	30'
45+00	30'	30'
50+00	30'	30'
55+00	30'	30'
65+00	30'	30'
70+00	30'	30'
75+00	30'	30'
80+00	30'	30'

STA.	LEFT	RIGHT
85+00	30'	30'
90+00	30'	30'
155+00	30'	WEST ONLY
160+00	30'	30'
165+00	30'	30'
170+00	—	EAST ONLY 30'
175+00	30'	30'
180+00	30'	30'
185+00	30'	30'
190+00	30'	30'
195+00	30'	30'
205+00	—	EAST ONLY 30'

