


10<sup>th</sup> mo. Oct. 29<sup>th</sup> 1827

Survey no 92

Surveyed for Elias Carl: Beginning at 2 iron rods and  
 fallen sugartree, westerly corner to Wesley Browder's land  
 thence with his line  $S 52^{\circ} E$  114 poles to a bar oak red  
 oak and elm, thence  $S 38^{\circ} W$  57 poles to 2 small sugar  
 trees and hickory thence  $S 52^{\circ} E$  63 1/2 poles to 3 sugartrees  
 thence  $S 38^{\circ} W$  57 poles to a small white oak small  
 hickory and large sugartree in McArthur's thence with  
 said line  $S 52^{\circ} W$  907 to 2 sugar

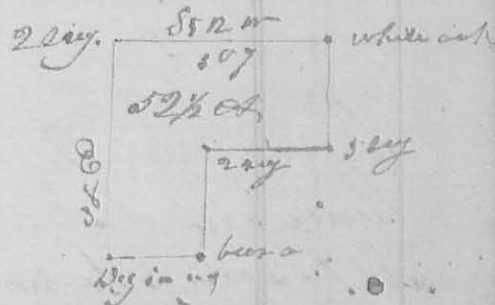

tree corner to Charles Carl's land  
 thence with his line  $S 38^{\circ} E$  114  
 poles to the beginning contain  
 ing 52 1/2 acres


Elias Carl

11 mo. (Nov) 7<sup>th</sup> 1827

8215

Survey no 93

Surveyed for Peter Harmon: Beginning  
 at a sugartree stump, in the road leading from Jonesfield  
 to Millford, corner to Samuel Davis survey  $S 32^{\circ} E$ . Thence  
 with a line of said survey  $S 15^{\circ} E$  (allowing for easterly varia-  
 tion, 128 poles) hence the present bearing is  $S 14^{\circ} E$ , 117 1/2 poles  
 (cuping a branch at 65 poles) to 2 small beeches original  
 north westerly corner to said survey (2 small sugartrees  
 have been marked here), thence with Davis's north line  
 $S 15^{\circ} E$ , (easterly variation), cuping a branch at 30 poles run at  
 66 poles, 79 poles to 2 beeches north west corner to Aaron Brown's  
 land, thence with Brown's west line  $S 15^{\circ} W$  (one degree easterly  
 variation), 128 poles to a stake in  
 the centre of the above named  
 road, thence with said road  
 cuping a branch  
 $S 76^{\circ} W$  80 poles to the beginning  
 containing sixty and a half acres  
 part of Samuel Davis's laid survey on  
 the waters of Mad river

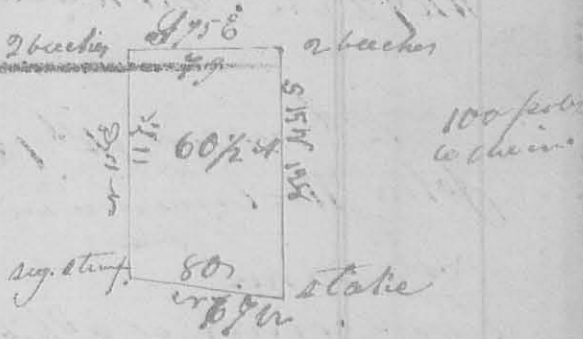

Peter Harmon  
 Aaron Brown jr.

Peter Harmon