

124 John { 10th Oct, 7th 1830 ✓ Surveyed 154.
 Makumson } Surveyed 164 acres for John Makumson.
 v. 153 Beginning at a stone, the corner of sect 31, 32, 35, & 36, T. 3, R. 14
 8253 Mds. set in a prairie 10 links north of a Spring branch; thence
 north with the original line 162 poles to a stake in a prairie or sec.
 corner between sect 26 & 32; thence west 162 poles to a stake, a bar
 oak 20 in diam. 168 ft 44 links dist. Thence south 162 poles to
 a stone, the gr. sec corner on the
 line between sect 31, 32 thence
 east 162 poles to the beginning
 it being the S.E. gr. of the sec
 32 T. 3 R. 14. U.S. 13
 Robert Humphrey's
 Wm Moore
 James McEwan's
 66


Thos Butler { 10th Nov. Oct, 2nd 1830 ✓ Survey 155
 v. 155 Surveyed 231 acres for Thomas Butler
 8254 Beginning at a buck sugar and cherry tree, the cherry tree is
 down in the west line of Alext. J. Dandridge survey v. 10 3220,
 and south east corner to his survey v. 44 78, thence north with
 the west line of the former survey, crossing the road from Belle
 Fontaine to Jawsfield at 80 poles, 1320 poles to a dogwood to a
 sugar tree hickory and buck N.W. corner to survey v. 10 3220, thence
 with the north line of the original survey East crossing a branch
 at 120 poles, 163 poles to thin beeches { Sagartia
 and dogwood v. N.E. corner to hickory & buck } 6 16 $\frac{1}{2}$
 J. Joseph Dickinson's land
 thence with his west line south
 crossing a branch at 88 poles, 163 poles
 to a stake in a marsh N.W. corner
 to Dickinson; thence with his
 south line East 16 $\frac{1}{2}$ poles to the
 west side of the water in a N. Keys
 blue ash hand white up trunk
 branch; thence down the creek with
 its meanderings crossing said road
 to 2 sugar trees on the west bank of
 the creek 23 $\frac{1}{2}$ poles east of the beginning; thence west 23 $\frac{1}{2}$ poles to the

beginning containing 93 $\frac{1}{4}$ acres in the north west corner of David
ridges survey N° 322 to

Baneth 11 M^o. Nov, 13th 1830
Survey N° 156

Survey N° 156
Surveyed 84 $\frac{1}{4}$ acres for Isaac Jane 8188

Beginning at a sugar tree and buckeye at the north east corner of former Calderwoods survey N° 3137 and south easterly corner to his survey N° 3139; thence with the line between said survey N° 75 $\frac{1}{2}$ W crossing Sugarcamp branch at 58 poles Mad River at 156 again at 163, and again at 176 poles, the road from Janefield to Sandusky at 242 poles, 410 poles to an elm small ash and white oak N.W. corner to Calderwoods Survey N° 3137 thence N 15 $\frac{1}{2}$ W with the original line 34 poles to a small cherry tree white oak and dog wood N.W. corner of Isaac Jane's land conveyed to him by Lucas Sullivan, thence with his north line N 15 $\frac{1}{2}$ E 410 poles crossing the above named road at river and Sugarcamp branch, to 2 beeches, and dog wood in the east line of the original Survey, and N.E. corner to S. Jane, thence with said line N 15 $\frac{1}{2}$ E 34 poles to the beginning, containing 84 $\frac{1}{4}$ acres off the north end of Survey N° 3137.

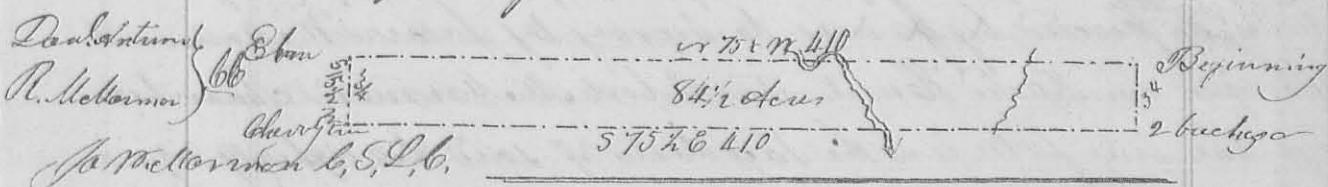

Isaac Janeth 11 M^o. (Nov.) 13th 1830
Survey N° 157
Surveyed 35 $\frac{1}{4}$ acres for Isaac Jane 8188

Beginning at a sugar tree and buckeye at the N.E. corner of former Calderwoods Survey N° 3137; thence with the north line of said Survey N 75 $\frac{1}{2}$ W 244 poles, crossing Sugarcamp branch at 58, Mad River at 156, at 163 and at 176 poles, to the centre of the road from Janefield to Sandusky; thence with said road N 17 $\frac{1}{2}$ W 177 poles to a stake in a line run by A.L. Hunt; thence with said line N 17 $\frac{1}{2}$ E, crossing the river and Sugarcamp branch, 239.5 poles to a beech and dogwood in the east line of the original Survey, thence with said line N 15 $\frac{1}{2}$ E 20.7 poles to the beginning containing 35 $\frac{1}{4}$ acres

Danl. Antiney
R. McElroy

Survey N° 157
Surveyed 35 $\frac{1}{4}$ acres for Isaac Jane 8188