


8516

35

Survey
#552

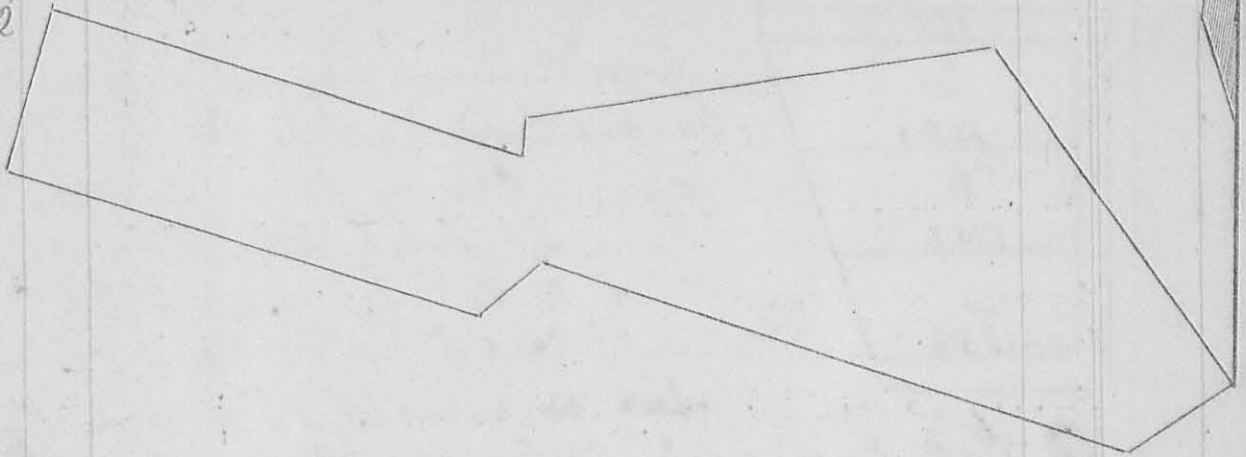

Surveyed Jan 20th 1826 for Mary A Thurman the above tract of land being Survey # 10426, 10427, 11041, as follows; Beginning at 3 Beech & a Beech-eye (an oak gum) & run N 72° W 192 poles to 2 Beech & a Sugar, then S 52° W 26 poles to a Sugar, Beech, & cherry (cherry gum) then N 73½° W 154 poles to a Beech (dead) then N 16½° E 52 poles to 2 Beech then S 73½° E 154 poles to 2 Beech & a Sugar then N 6° E 12 poles to Red Oak 2 Beech & Sassafras (all gone but R.O.) then N 81° E 128 poles to an Oak & Beech, then S 36° E 130 poles to a Black-Walnut Beech & Hawth then S 53¼° W 4½ poles to the Beginning Containing 10577/100 Acres

A. Harrison
C D L C C