

Not Compared


Surveyed for —
Chas. A. Stephenson

Pt. Survey 3317

Lake Township

July 18, 1907

159
INDEXED ON MAP

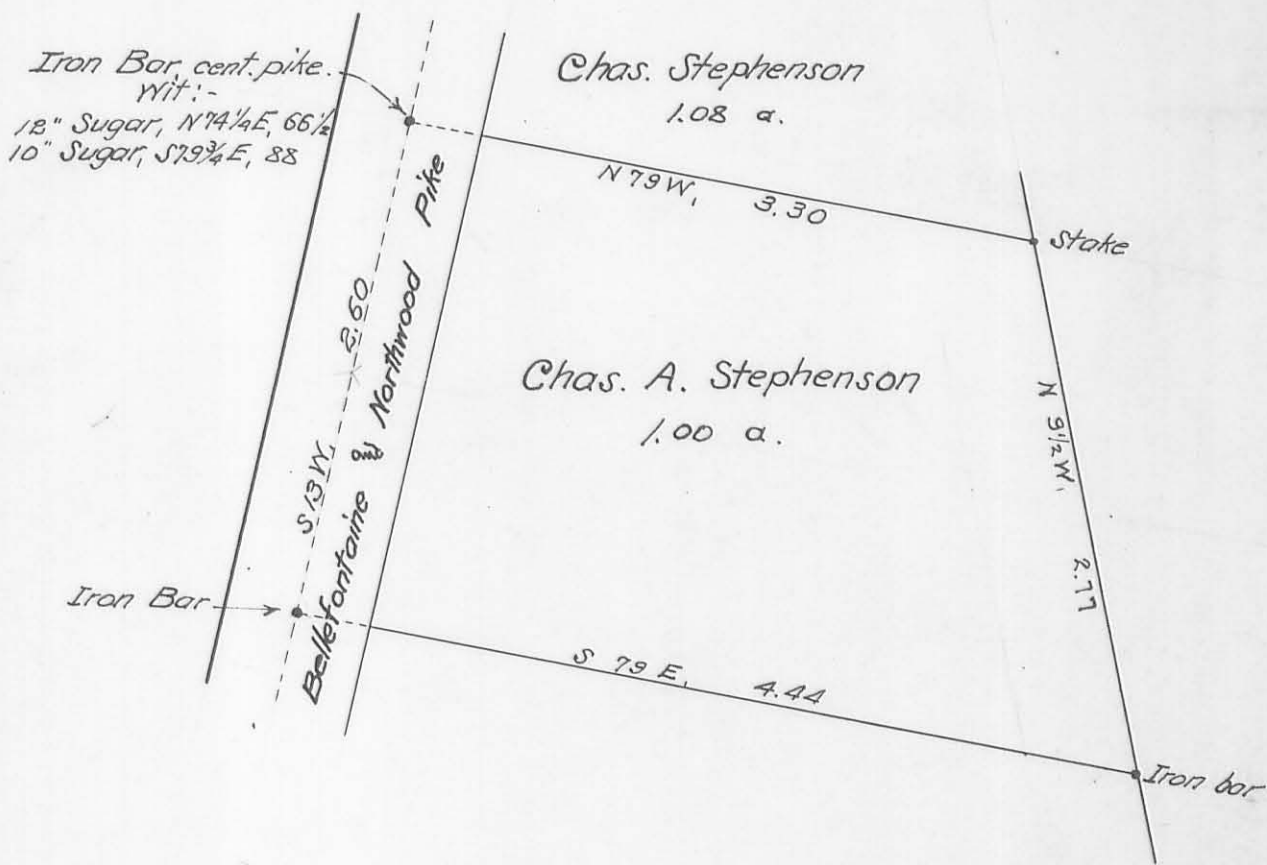

Field Notes Book 55 Page 22
H.S. Dalkey surveyor.

Survey 3317
Chas. Stephenson 1/2

Coe pile, between pin at
Stephenson's \leftarrow S 14 $\frac{3}{4}$ W
(Seed = (S 13 W)
Variation $1\frac{1}{2}^{\circ}$ Left

Coe S. line S 79 E
(Seed (S 80 $\frac{1}{2}$ E,)) $1\frac{1}{2}$

Random

produced line S - 2.90

run N to S. line

S. line (random) 4.565

E. line (") 3.08 N 9 $\frac{1}{2}$ W

57
INDEXED ON MAP

Lake T.P. H.S. Daiter 22
July 18-07

Commence iron bar in pile
at SW \leftarrow Stephenson's 108 a pc.

- with cent pile S 13 W, 2.60
to iron bar in pile

- S 79 E, 4.44 due to iron bar

- N 9 $\frac{1}{2}$ W, 2.77 to stake at
NE \leftarrow said 105 a pc

- with S. line said 109 pc -
N 79 W, 3.80 to begin = 1 acre

with beginning 12" Sugar N 74 $\frac{1}{2}$ E, 6.6 $\frac{1}{2}$ lbs

10" Sugar S 79 $\frac{1}{2}$ E 88

note: this bar is in line with row
of Sugars, S 79 $\frac{1}{2}$ E

Map Book D Page 5
see Book 549 Page 25
for 3 acres added to
East side