

Koons survey
Lake Twp.
sec. 33 T.4 R. 14

Found old hubs at lot
corners checked. O.K.

Placed Irons as shown.

See Drawing of Lots Lake
Twp. Survey 1177. Lot
Survey By crane
(Note Lots not recorded)


1177
INDEXED ON MAP

March - 19 - 1932
cloudy
Wright
Bill Wright

Silver
Lake Pkwy

63

Detroit St.

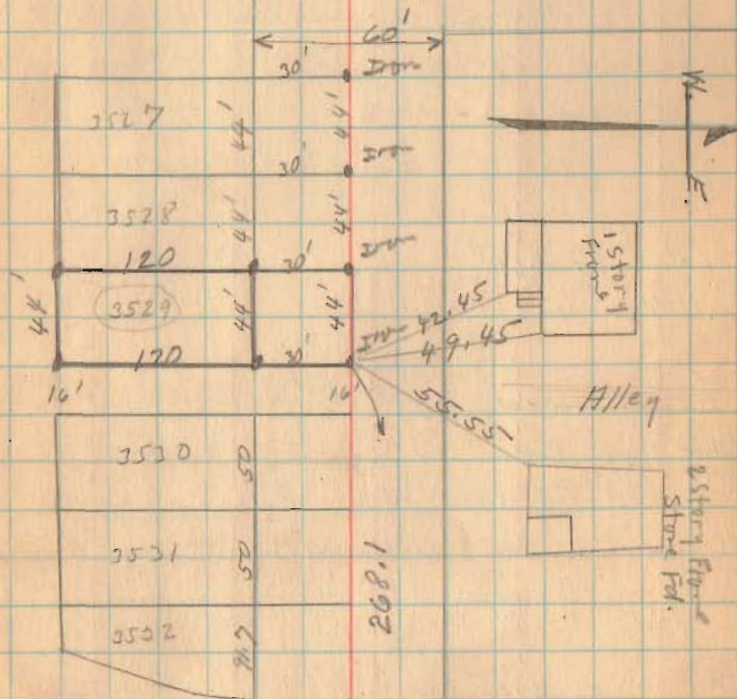

S.H. 189
Route 53

Monument
with corner

S. Main St.