

Road 219
Lake Twp.

Status Plowed 20' from E for 40' Road
Status 2-4-6-8-10 etc.

Trustees getting land for 40' Road


(1298)
INDEXED ON MAP

Jan. 10-1932

cloudy

Wright
Mr. Wish
M. Shick

72

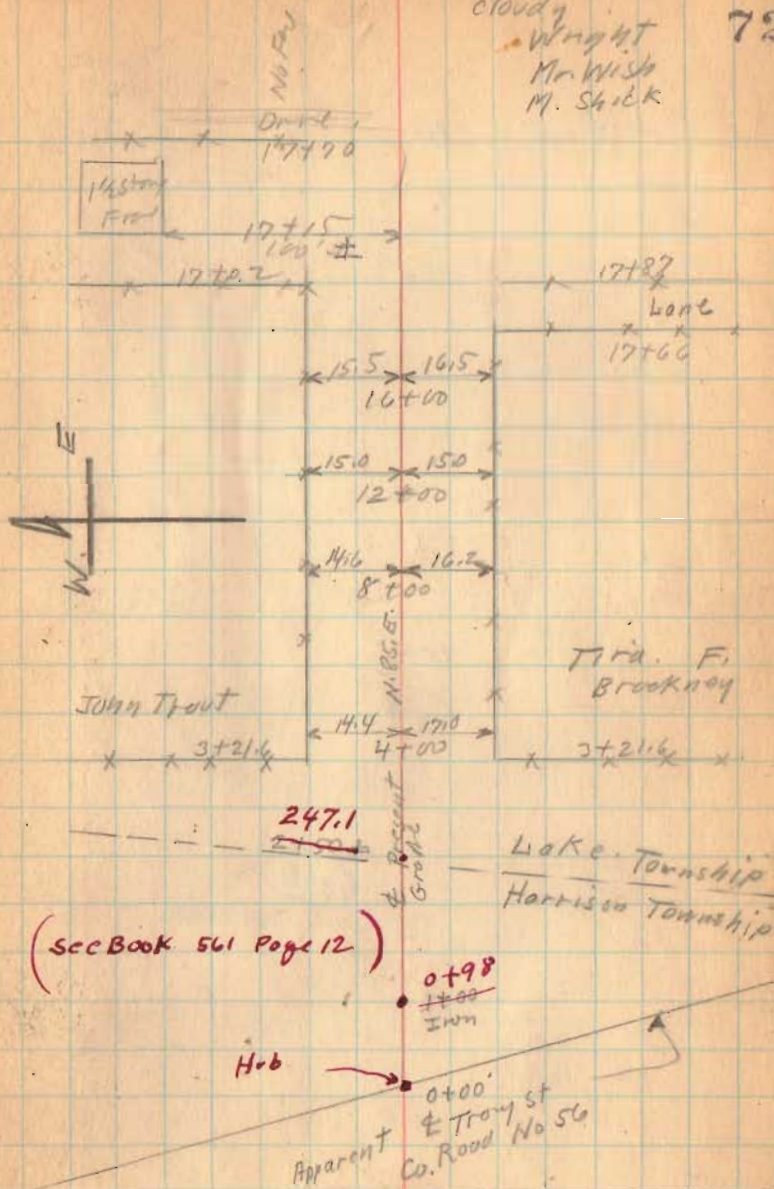

Road No. 219


4000
51
3949

2700
13
2687

(298)
INDEXED ON MAP

1-10-32

73

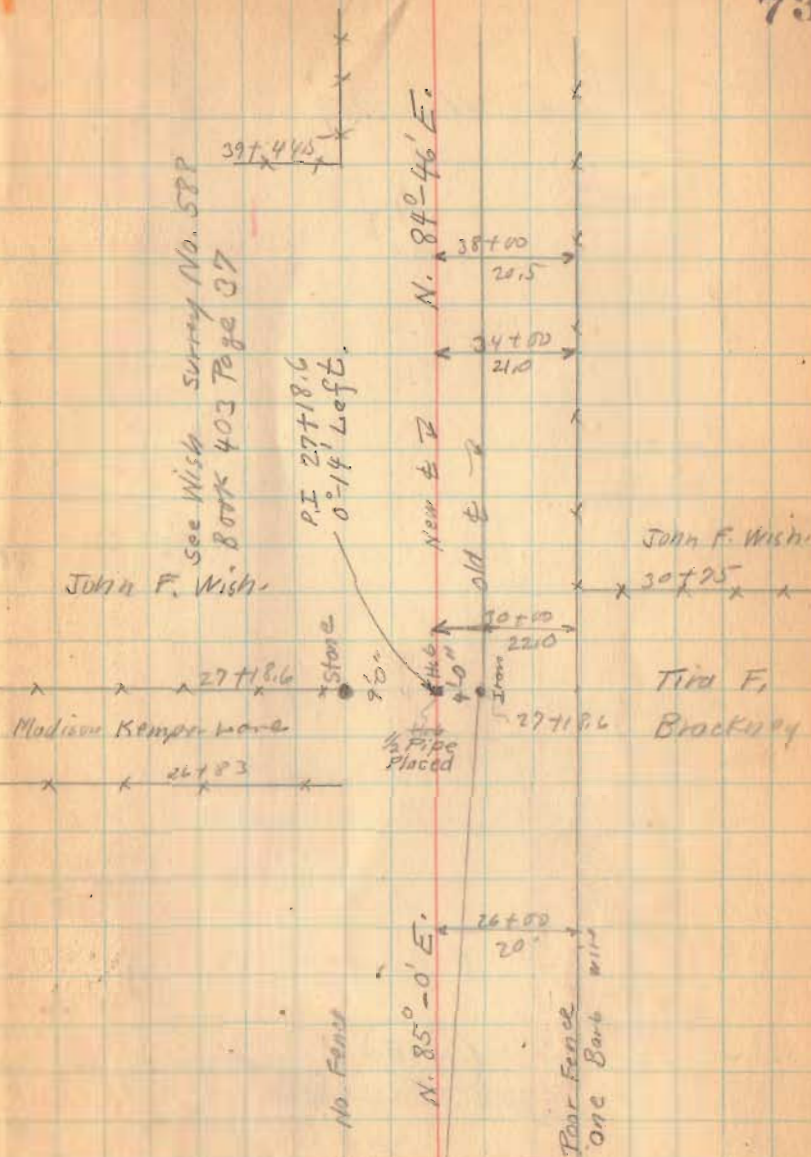

Road No. 219

$29\frac{1}{2}$
 $\frac{1}{1}$

$\frac{13}{5}$

1298
INDEXED ON MAP

see Harvey Survey
No. 1221 B.M.K. 572 Page 29
Herman
Harvey

Line
46+44
John F. Wisk.

121.6
46+00

N. 88° - 46' E.

40' 0"

190' 0"

old

1-10-32

74

1.25'

Milton Shick,

46+44

John F. Wisk.

20'

44+50

44+01
70' ±

21'

History
Frd.

DRIVE 42+70

42+61

111.5

42+00


195'

Road No. 219

P.I. 52+42.73
 Δ 37° 35' Left.
 D. 12°
 R. 478.34
 T. 162.73
 L. 313.19
 E. 26.92



P.I. 48+54
 Δ 38°-0' Right
 D - 16°
 R - 359.26
 T - 123.69
 L - 237.50
 E - 20.69

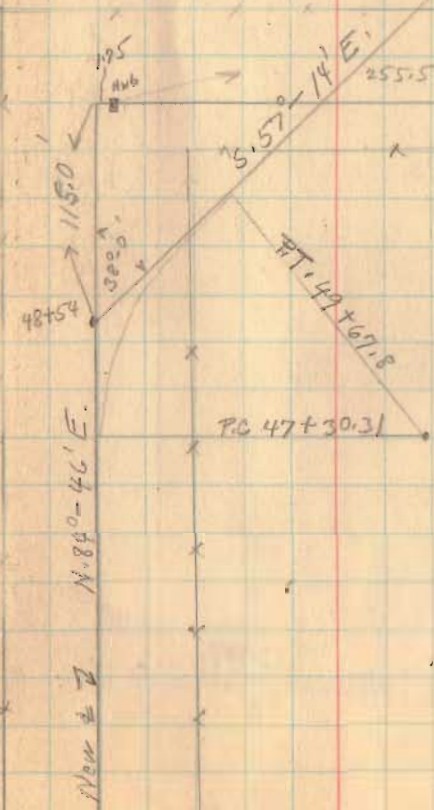


1298
 INDEXED ON MAP

Road No. 219

Jan - 11 - 1932
cloudy

Wright
Mr. Wish

76

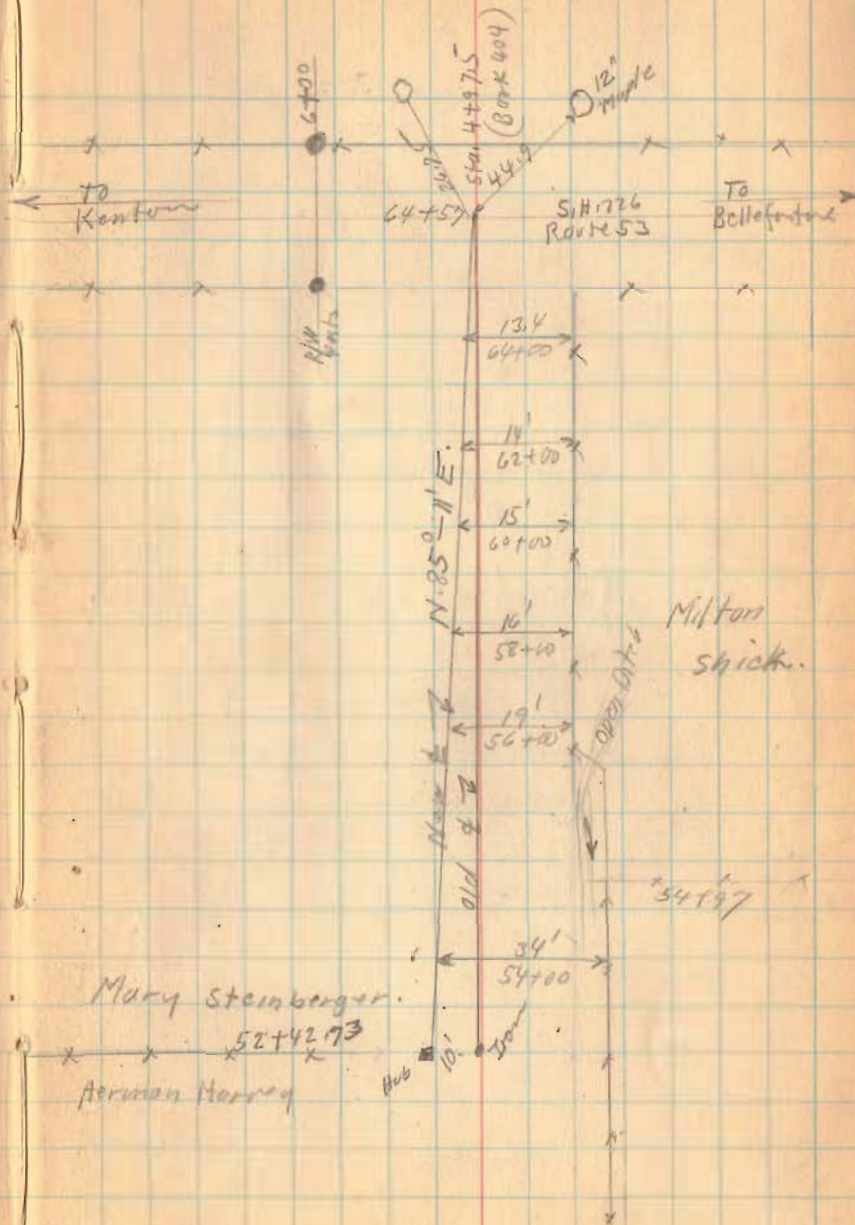

1298

INDEXED ON MAP