



2/23/43

City Engineers Record

Iron bar set in position of old section stone.

See City Engineer's Record

Iron pin 1 1/8" x 30" found witnessed by City Engineer's Records. Said iron bar removed and concrete Monument 48" long set approx. 0.3' below road surface at exact position of iron bar mentioned above and in City Engineer's Record.


Lawrence KERN

R.H. Reed

Monument drilled and stamped as directed above

R.H.R.

3-23-43

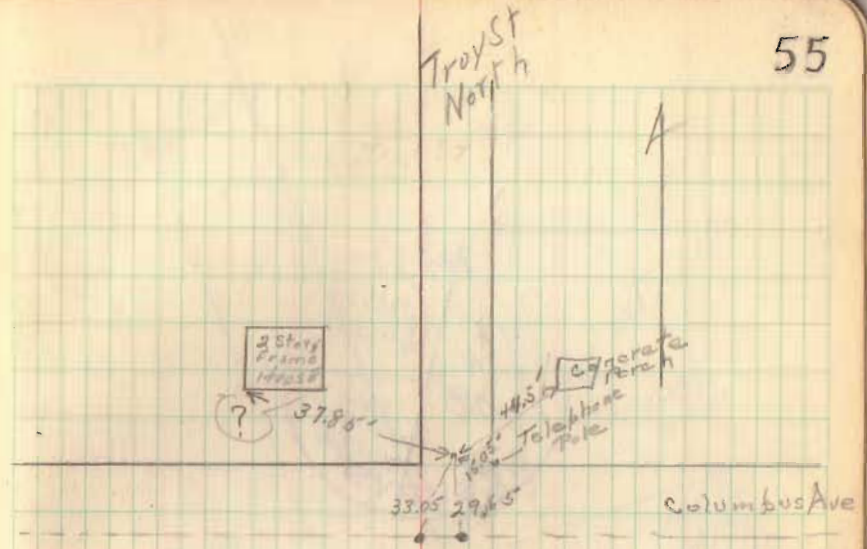

Harrison

Lake
2667

Witness from Thesis
O.S.U. 1943

INDEXED ON MAP

"Extension and Application
of Horizontal Control
By Coray, Harper & Mavromatis

SEE Field Book
654-P28

Troy St
South