

Peters Survey Lake Township January 1965 2.95 Acres

The following described LAND in Lake Township, Logan County, Ohio and being in V.M.S. 3317.

Beginning at an iron in the center of County Road Number 9 known as the Bellefontaine - Rushsylvania Pike at the S.E. corner of a 0.62 acre tract now in the name of H.E.Houchins and said beginning point being Station 15 plus ~~60~~ as shown in Logan County Engineer's Field Book Number ~~577/page~~ 578⁶⁸ Page 12.

Thence with the center line of County Road Number 9 S. 33° - 17' W. 212.10 feet to a small iron.

Thence N. 46° - 23' W. 456.00 feet to the S.W. side of a large wood post. The last described line passing an iron at the west side of County Road Number 9 at 30.50 feet. (Being 30.00 feet from the center line when measured at right angles)

Thence N. 23° - 16' E. 302.00 feet to an iron. Said iron being at the S.W. corner of a 2.73 acre tract ~~now in the name of~~ now in the name of ~~Russell Pulfer~~. ^{Scherer} ~~Johan A. Scherer (6-13-69)~~

Thence with the south line of said ~~Pulfer~~ ^{Scherer} tract S. 54° - 50' E. 325.70 feet to an iron at the N.W. corner of a 0.62 acre tract now in the name of H.E.Houchins.

Thence with the west line of said Houchins 0.62 acre tract S. 35° - 10' W. 150.00 feet to an iron.

Thence with the south side of said Houchins 0.62 acre tract S. 54° - 50' E. 180.20 feet to the place of beginning. The last described tract passing an iron at the west side of County Road Number 9 at 150.20 feet.

The above described tract contains 2.95 acres.


cc
Logan County Engineer



ID
3768

INDEXED ON MAR

on Plat Book
3/15/65
D.E.G.

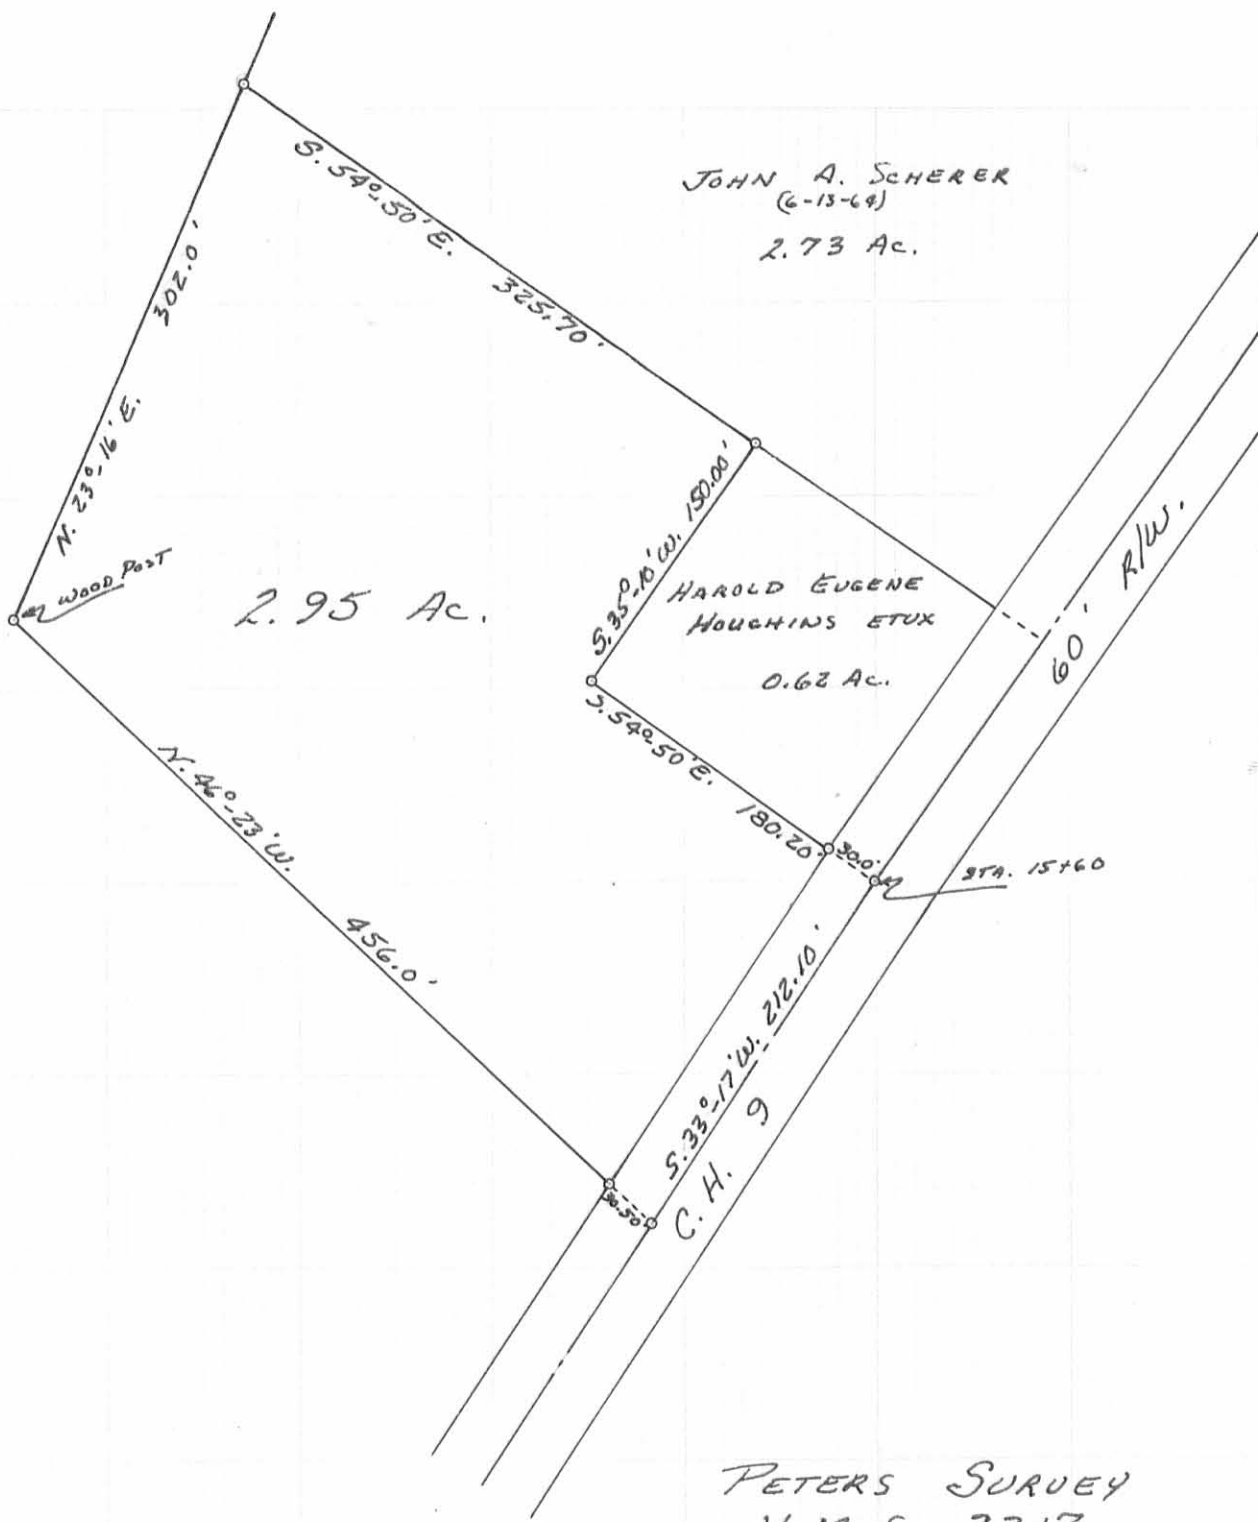

o - IRONS

PETERS SURVEY
 V.M.S. 3317
 LAKE TOWNSHIP
 LOGAN COUNTY, OHIO
 SURVEYED BY F.F. WRIGHT
 JANUARY 1965
 SCALE: 1" = 100'

DRAWN BY D.E.G.
 9/2/65

IP
 3768

INDEXED ON MAP