

11° E 324 poles (passed the gr. sec. corner at 162 poles a hickory
 west 6 links) 324 to corner of sec 22, 23, 28, 29, original corner
 trees yet standing - thence between sec 22, 23, S 89 1/2° E passed
 a stone at 162 poles the gr. sec. corner) 322 poles to the beginning
 The 1st line, being at the stone in the center of the north of
 the sec. thence south 162 poles a white oak S 40° E 26 poles
 322 poles to the gr. sec. corner in the south line -

The 2nd division line begins at the gr. corner in the
 line of the sec, a hickory west 6 L. thence 89 1/2° E 162 poles,
 passed the center corner, 322 poles to the gr. sec. corner in the
 east line 3rd division line begins at 89 1/2° N 78 poles from
 the last named corner at a stake, thence north 162
 poles to a stake in the north line of the sec 78 poles from
 its e. e. corner

Henry Melhamon }
 David Platt }

La. Melhamon
 C. S. G. C.

(8284)

10th mo, Oct, 27 1832

Surveyor No 197


Jo. Gordon 3

Surveyed fractional sec. 27, T4 N 14 E R14

for James Gordon; Beginning at the corner of

sec 27, 28, 33 & 34, the original bearing trees are all down -
 thence between sec 27 & 33 S 71° W 326 poles to the origin-
 -al corner of sec 26, 27, 32 & 33, a "white oak 120 S 57° W
 20 L, a white oak 67 S 43° L all down marked a white
 oak 120 N 24 L thence between sec 26 & 27 S 89 1/2° E, crossed

at Key break at
 160 poles) 234
 poles to the corner of
 26 & 27 a white oak
 or 256 32 L a white
 oak (the N 22 L
 in Ludlow's line
 thence with said
 line or 195 11 346
 poles to the corner of
 sec 27 & 28 trees down
 thence between said

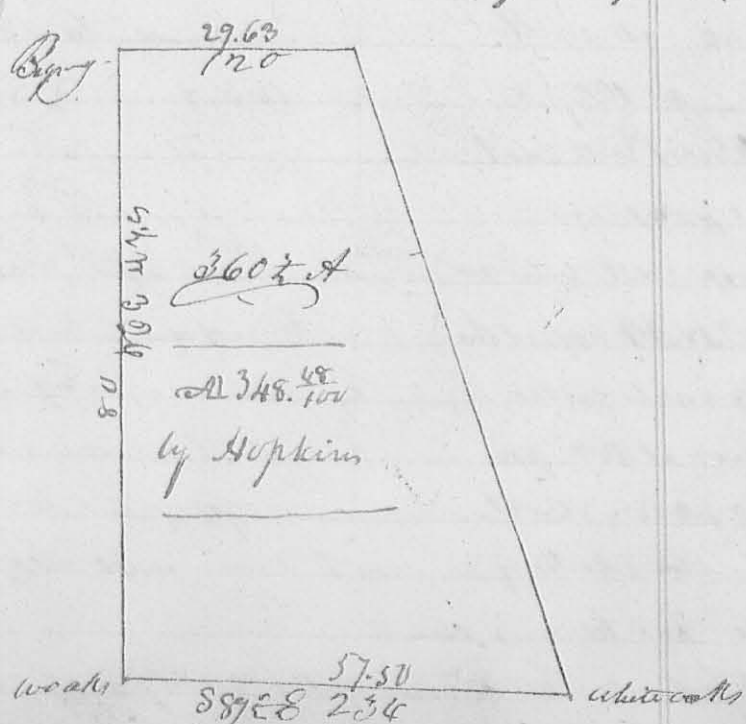

(white)

(white oak)

Sec. 189 1/2 N 120 poles to the beginning containing 360 1/2 acres

John Gunn }
Walter Gunn } 66

La Motte
C. G.

11th Mar. 1832

Survey 198

Geo. Smith }
Thomas Macumson }
Jonathan Rorton }


Surveyed the north half of Sec. 26
T. 3 R. 16. N. 13. for John Smith Thomas
Macumson & Jonathan Rorton as follows

8295

198

Beginning at the corner of sec 26, 27 & 28
a red oak corner tree; thence between sec 26 & 27

S 89 1/2 E 326 poles to the corner of sec 26, 27 & 28 a white oak S 85 E 142. a white oak N 87 W 50 L. - Thence between sec. 26 & 26 S 1/2 W 162 poles to a stake in a prairie in the east line of sec 26 - thence N 89 E measuring a branch at 42 poles 326 poles to a stake in a prairie in the west line of sec. 26 - thence N E 162 poles to the beginning containing 328 acres -

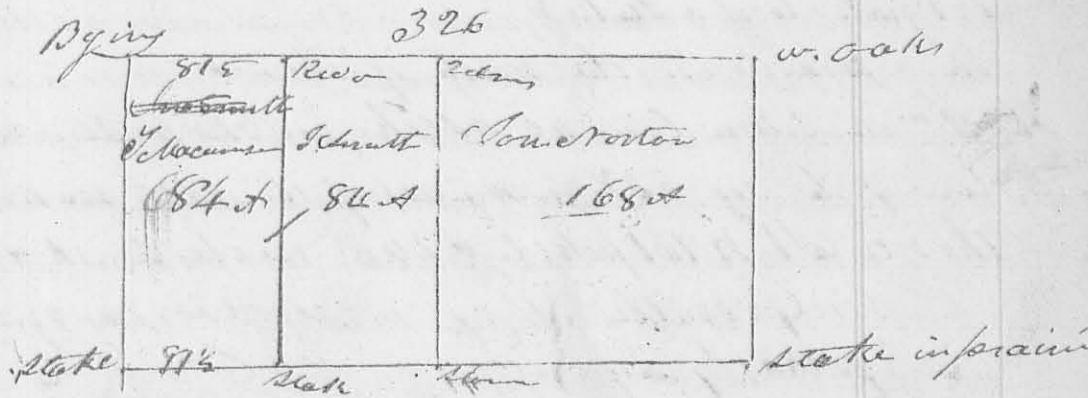

The 1st division line begins at a stake in the north line of the sec 84 poles from the N.W. corner of said sec a red oak S 85 E 142 a white oak S 1/2 W 162 poles to a stake in the south line of the half sec. - The 2nd line begins at a stone in the center of the sec. thence N 1/2 E at 84 poles marked a white oak N 63 E 56 L. a white oak N 86 W 33 L, continued 162 poles to 2 small stones & a red oak in the north line of the sec. in a swamp.

La Motte