




(1027) IP

INDEXED ON MAP

Lot survey  
Laba View

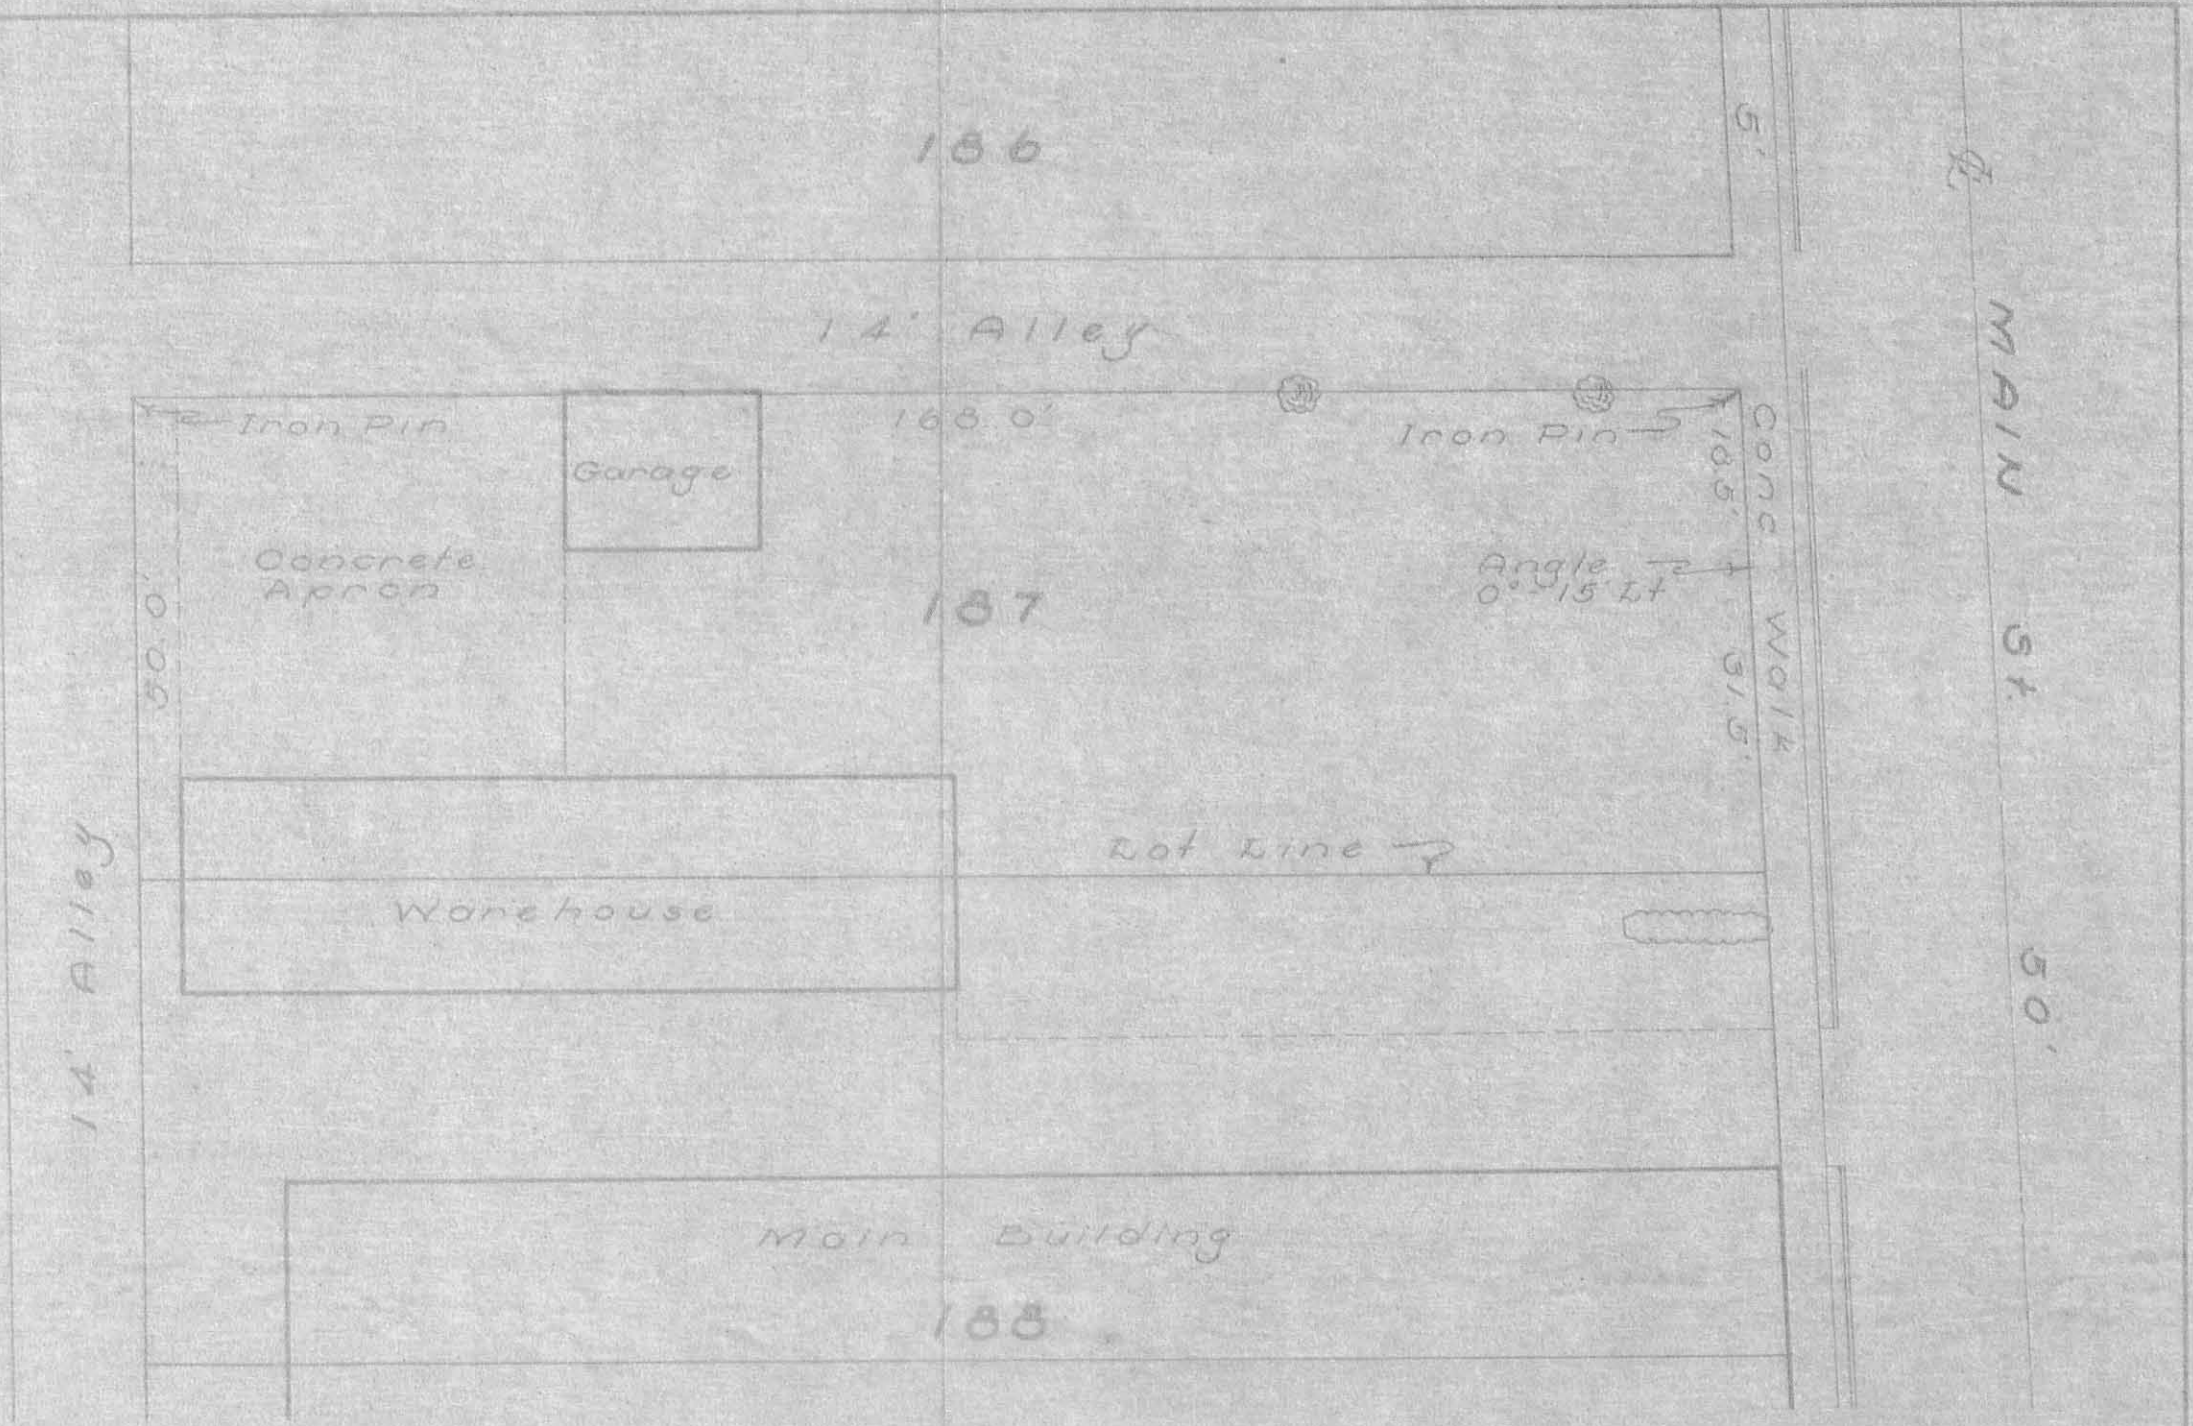


PLAT OF  
 LOT No. 187 - COUPLES 4<sup>th</sup> ADD.  
 LAKEVIEW OHIO  
 FOR THE  
 LAKEVIEW LUMBER Co.

Scale 1" = 20'

INDEXED ON MAP  
 1027 2P

Surveyed & Drawn by  
 Dan L. Dodson  
 Surveyor in Training  
 April, 1955

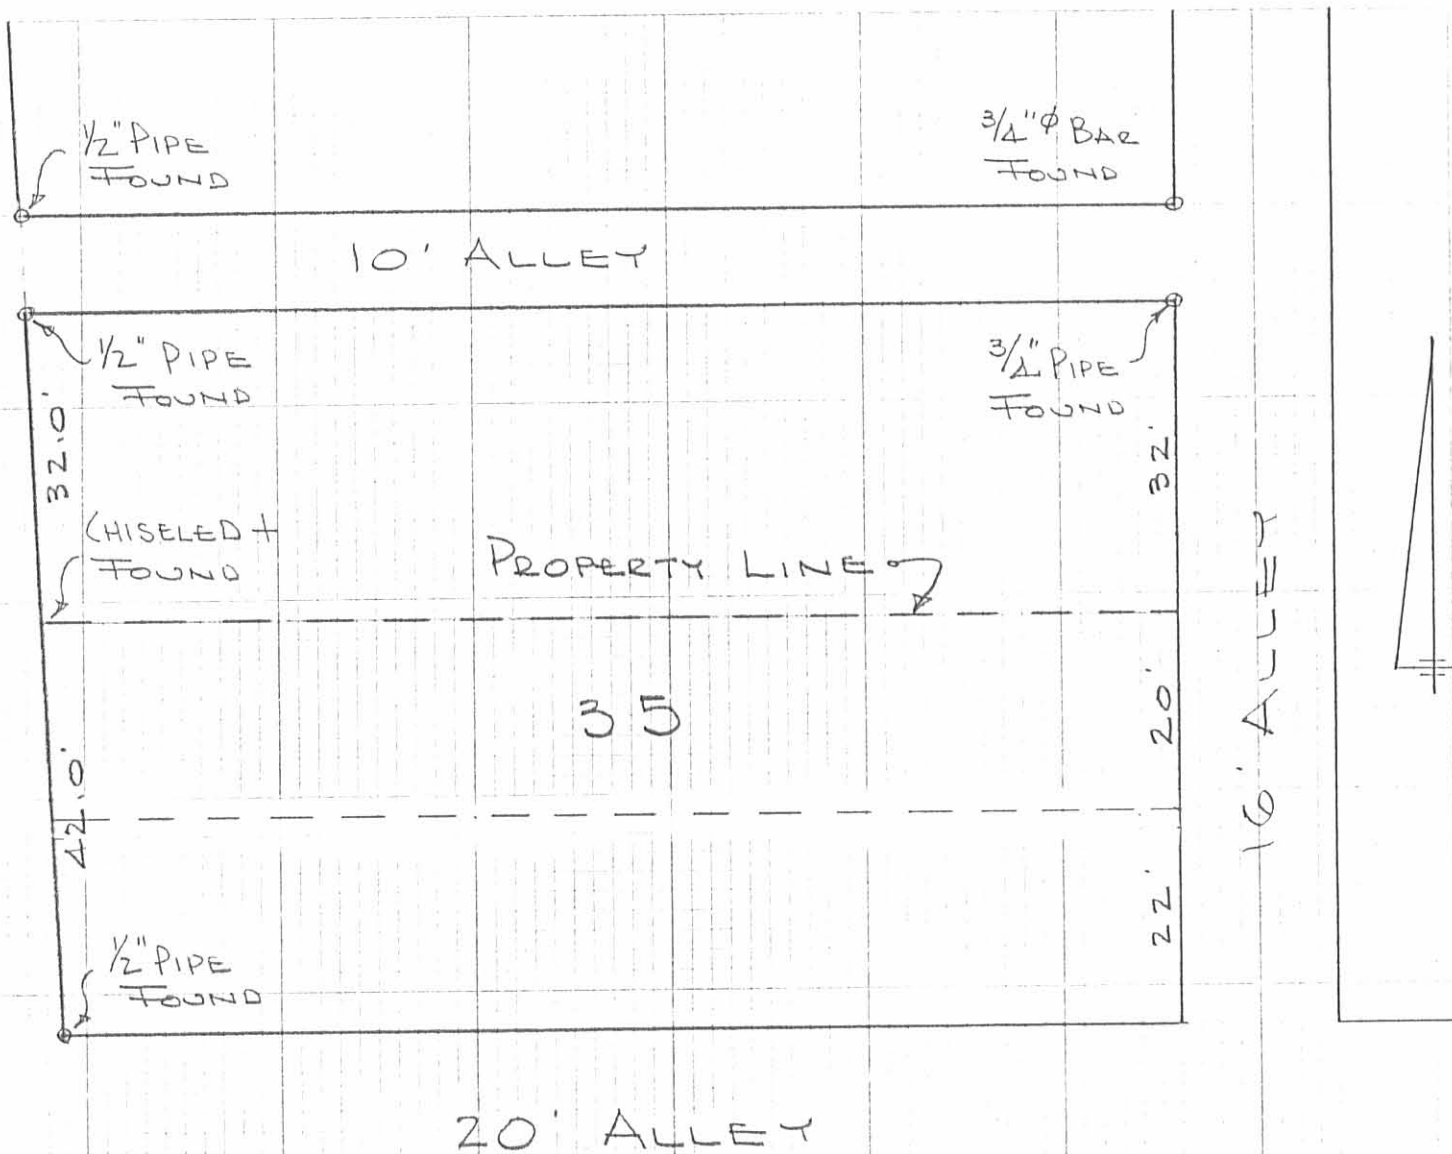

SURVEY OF  
 PART LOT No. 35  
 LAKEVIEW, OHIO  
 FEBRUARY 26, 1977  
 SCALE 1" = 20'

INDEXED ON MAP  
 1027 38

DAN L. DODSON  
 REG. SURVEYOR 4270  
 BELLEFONTAINE, O.