


# SANDERS ADDITION

(106)

## TO LAKEVIEW LOGAN COUNTY OHIO

INDEXED ON MAP

SCALE 1 INCH = 80 FT

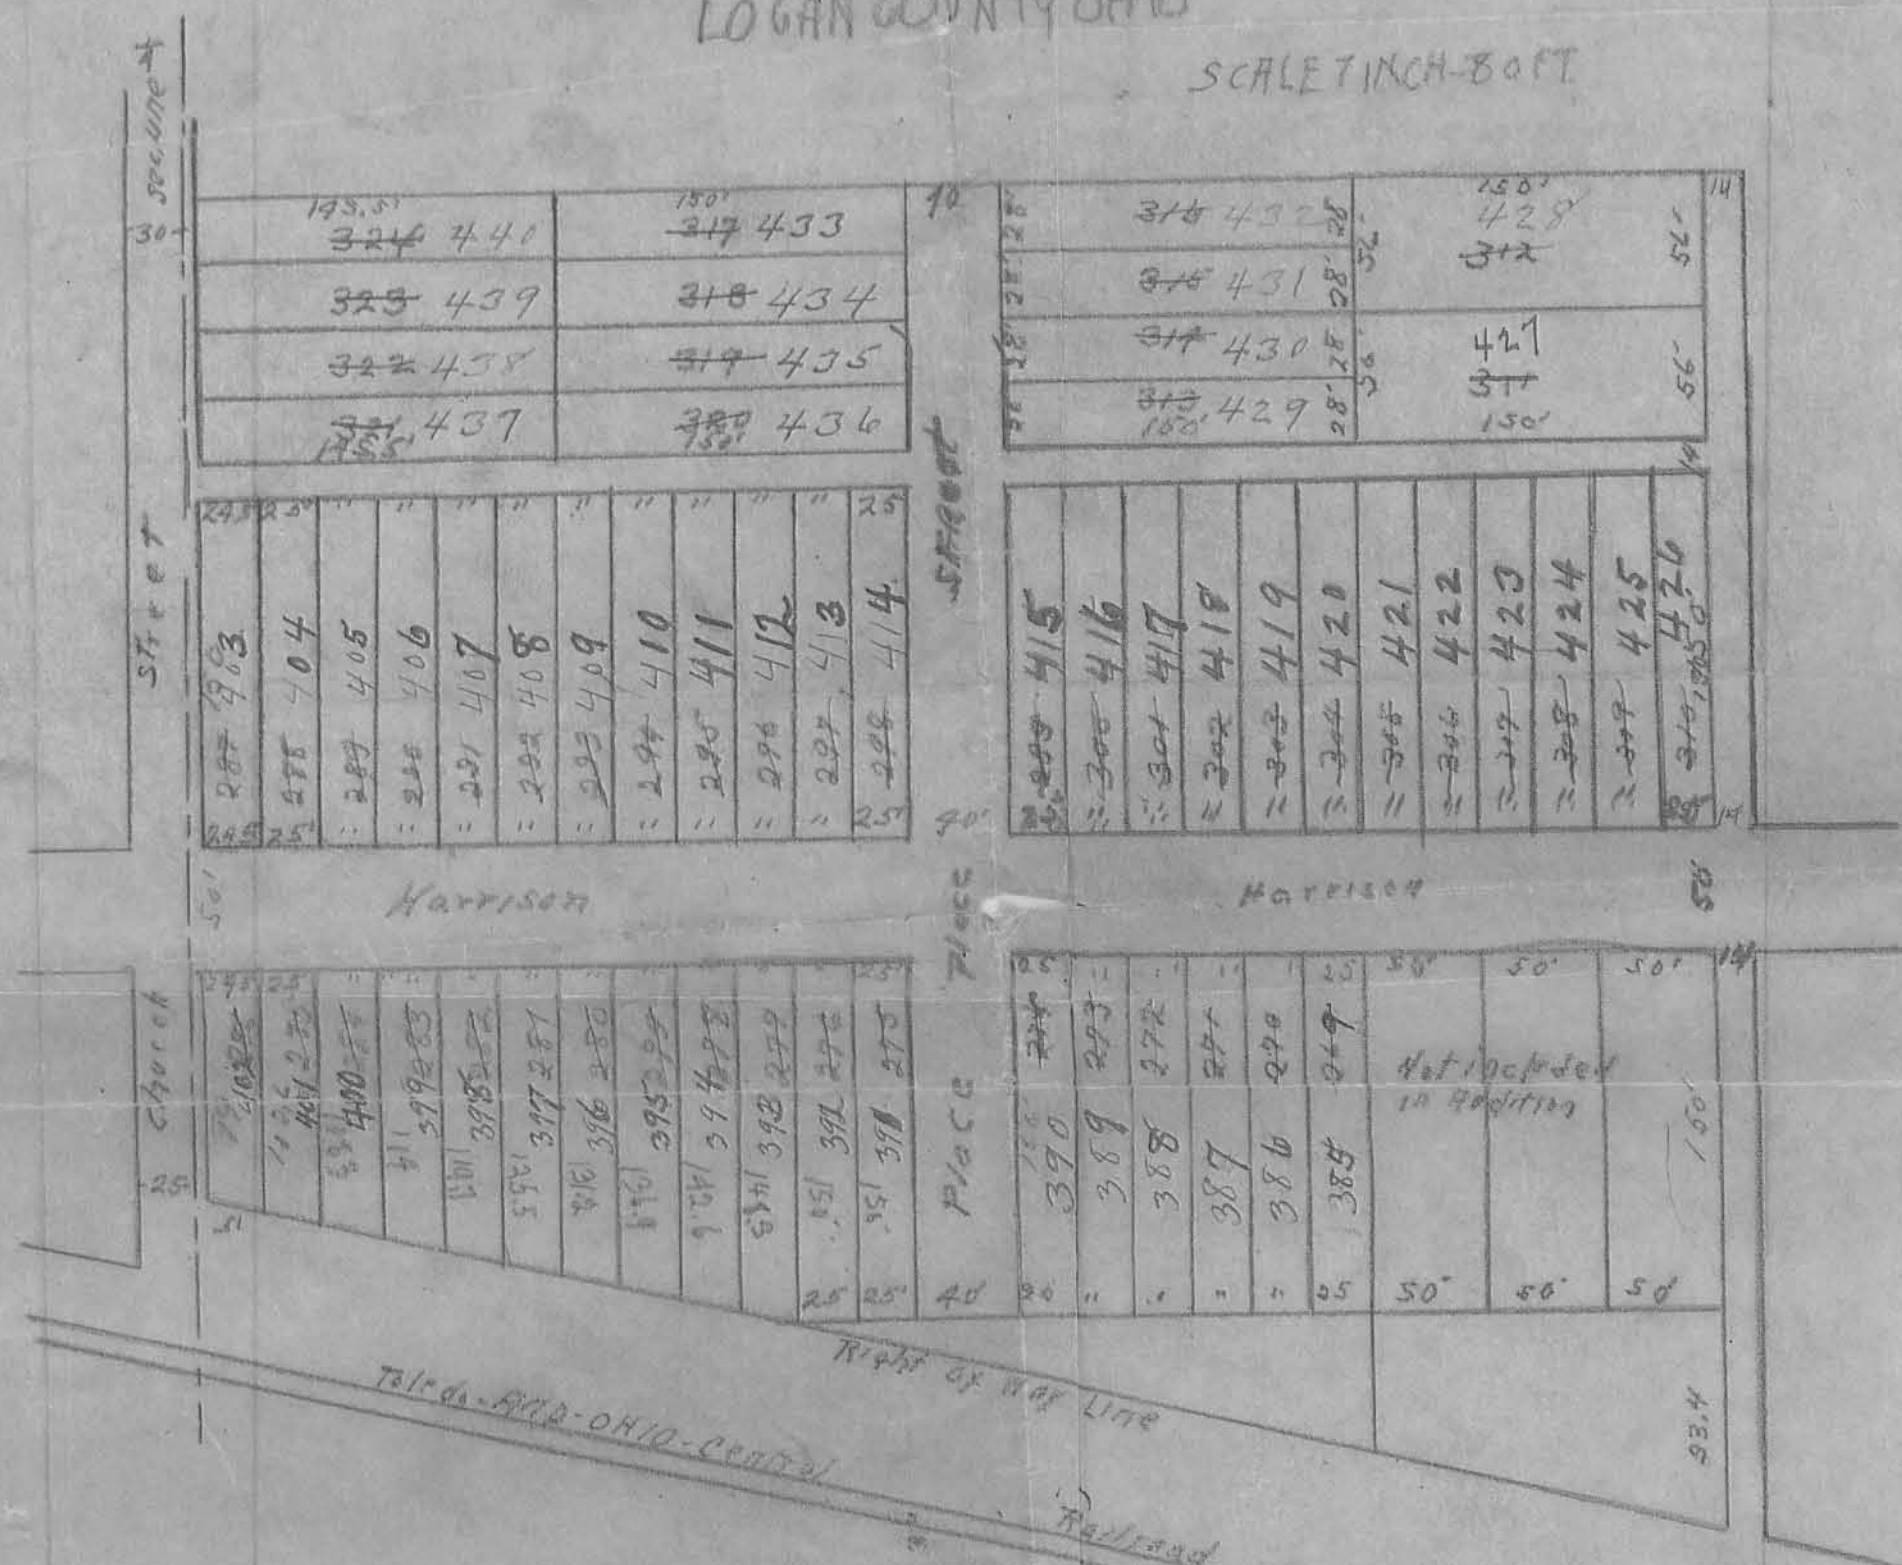

E. L. Vautson, Mayor  
Harry Tilgner - Clerk

I hereby certify that the lots of this plat have been renumbered on the Auditor's Duplicate according to new numbers which appear in red on this plat

W. W. Corbet  
County Auditor  
Per W. W. Corbet, Deputy

accepted by Council this day of June 1915  
James A. Mauer, Mayor  
Attest Guya Bayn, Clerk  
Lakeview Logan County Ohio

W. S. Bousman  
Fred Markley, Commissioner  
T. L. Hoover  
H. L. Hoffman  
H. H. Hoover  
Transferred 1-4-1915  
J. S. Van Hook, County Auditor  
In error.

11/14/50



25  
276  
24.8  
2755

# SANDERS ADDITION

TO


## LAKEVIEW

LOGAN COUNTY OHIO

1061 IP

INDEXED ON MAP

SCALE 1 INCH = 80 FT.

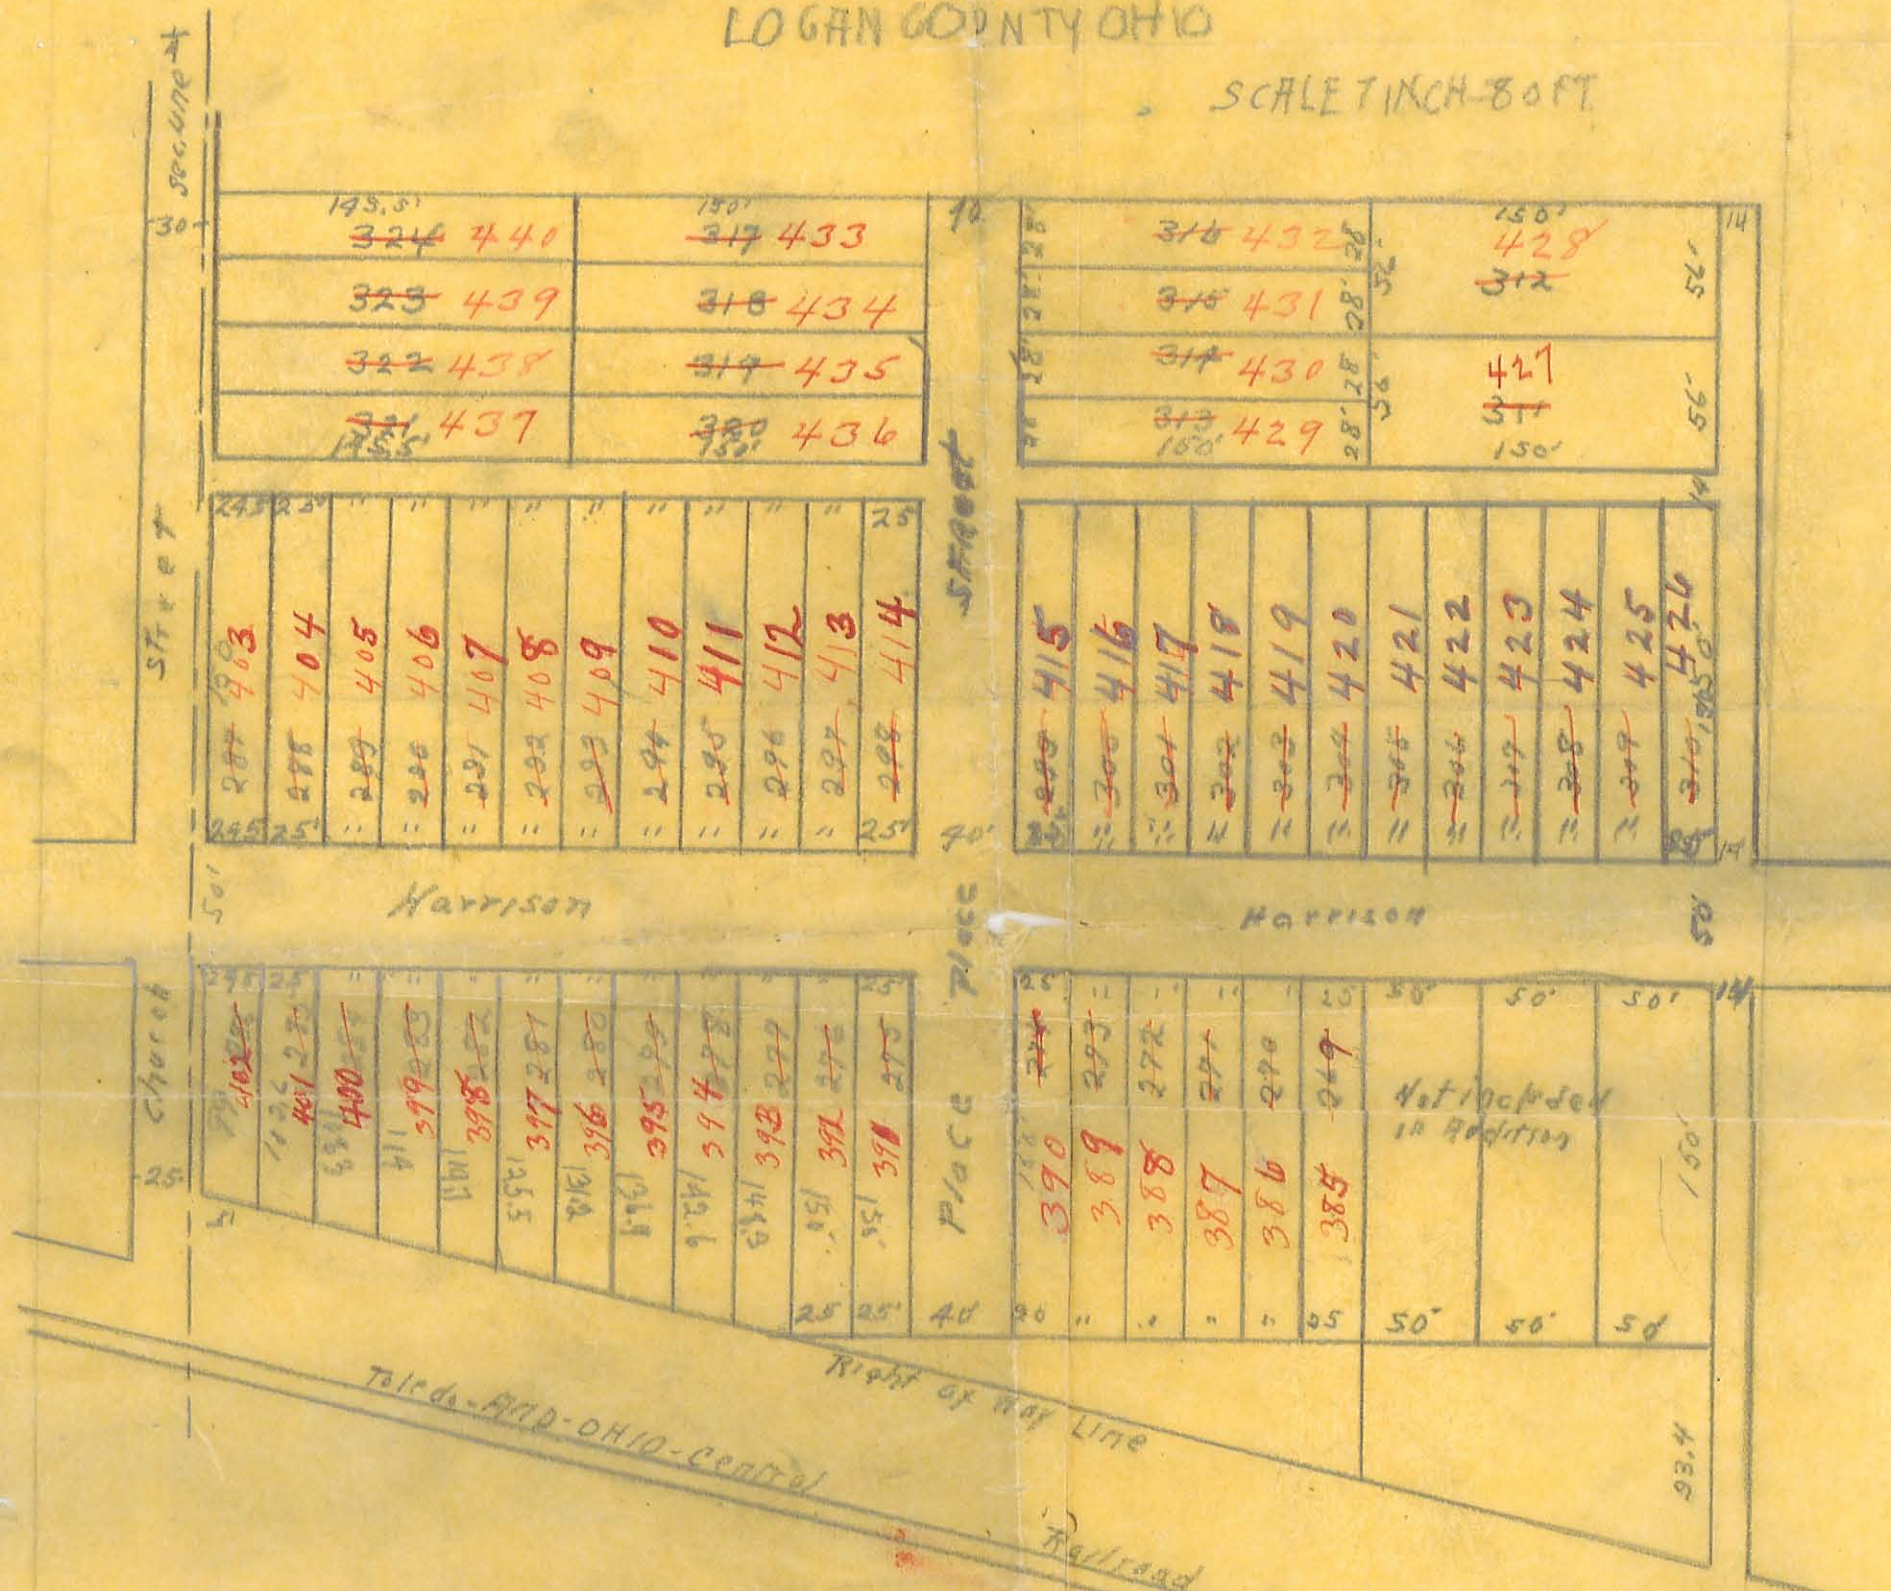

E. L. Vautson, Mayor  
Harry Tilgore - Clerk

I hereby certify that the lots of this plat have been renumbered on the Auditor's Duplicate according to new numbers which appear in red on this plat

W. W. Corbet  
County Auditor  
Per W. W. Corbet, Deputy

accepted by Council this day of  
June 1915 James A. Mauer Mayor

attest Guya Bayne Clerk  
Lakeview Logan County Ohio

W. S. Brunner  
Fred Mackley Councilman

F. L. Hoover

H. J. Hoffman  
H. H. Hoover

Transferred  
J. S. 1-4-1915  
in Logan County Auditor's  
In error.

1710.50