



## Survey for Stabler

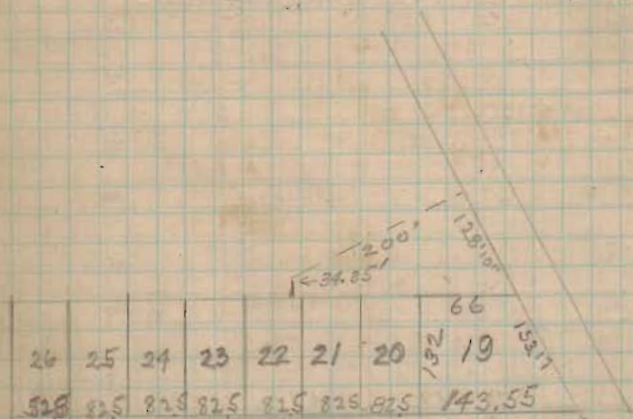

29.16  
17.54  
153.17  
93.27

24.15  
17.54  
82.5

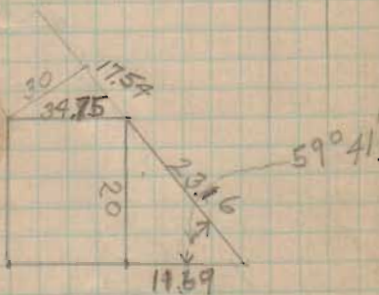

153.17  
17.54  
82.5

Lakeview Dec 22 1923

Iron set 2 ft south of property line



INDEXED ON MAP