

NICHALSON 4TH ADDITION.

STOKES TOWNSHIP
LOGAN COUNTY OHIO



- A - Iron found
- B - " Road
- C - Hub Road
- D - " "
- E - " "
- F - " "
- G - " "
- H - " "
- I - " "
- J - " "
- K - " "
- L - 7/4" Iron about 40" long
off center of East
side of 20" Elm
- M - Hub Road
- N - " "
- O - " "
- P - " "
- Q - old Iron Found.

Lots 486-492
Lakeview
June 7-1925
Chas
Fullbright
Bill Vingo

Dedication
This is to certify that Charles Nicholson owner
of the above property herein described,
caused the making of the accompanying
plat and does hereby dedicate to the
public use and convenience forever the
streets and alleys therein shown

The State of Ohio Logan County ss
Be it remembered, That on this day of June 15 AD 1925
before me the subscriber a Notary Public and for said County
personally came the above named Chas Nicholson the grantor
in the forgoing plat Deed and acknowledged the signing of
the same to be his voluntary act and deed for the uses and
purposes therein mentioned

In testimony whereof, I have hereunto subscribed my
name and affixed my official seal on the day and year
last aore said.
Edward H. Wadsworth
Notary Public
Logan County Ohio

Surveyors Certificate
The annexed plat is a correct representation
of Chas Nicholson's 4th addition to the village of
Lakeview, Ohio, in Section 27, Town 6, Range 8,
S.E. Quarter, surveyed by me, June 5th 1925,
containing 6 Acres of land. All measurements
are given in feet and tenths.

Approved *J.C. Mann*
Surveyor.
Approved by the town Council of Lakeview, O.
1925
Chas Nicholson Mayor.

Received for record JUNE 20th 1925
Recorded JUNE 20th 1925
In Plat Book B, Vol. 2 PAGE 96
Transferred *DAVID H. CARTER*
June 20th 1925 Recorder
N.W. Corbet - Auditor - 866


1581

REC'D 3-5-96 Spwy OK

LEGEND:

O = 5/8 INCH IRON
BAR SET

SCALE: 1" = 30'

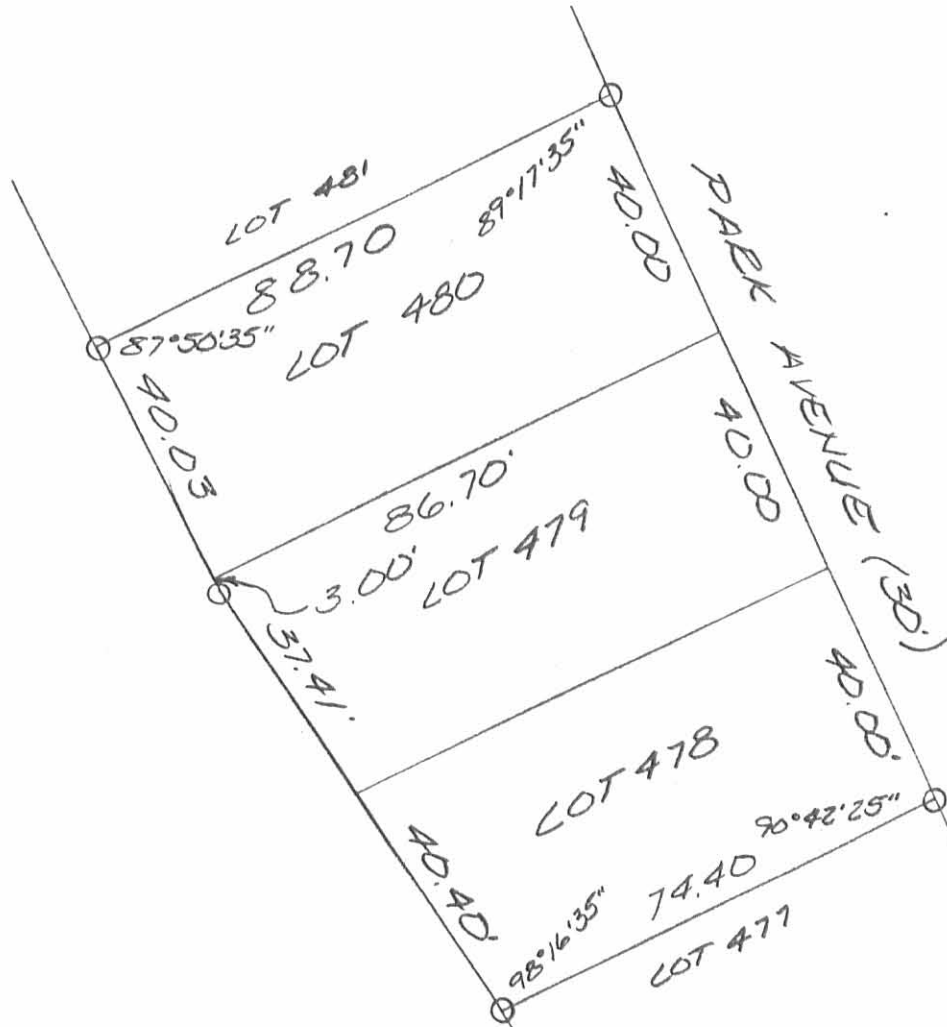

SURVEY OF LOTS
478, 479, 480 IN THE
VILLAGE OF LAKEVIEW,
STOKES TOWNSHIP, LOGAN
COUNTY, OHIO FOR
RON RIGBY ON
MARCH 5, 1996



MAP
1581 2P

Leslie H. Geeslin
LESLIE H. GEESLIN
EUSHSVLVANIA, O
(513) 468-2793