



STEPHENSON

STREET

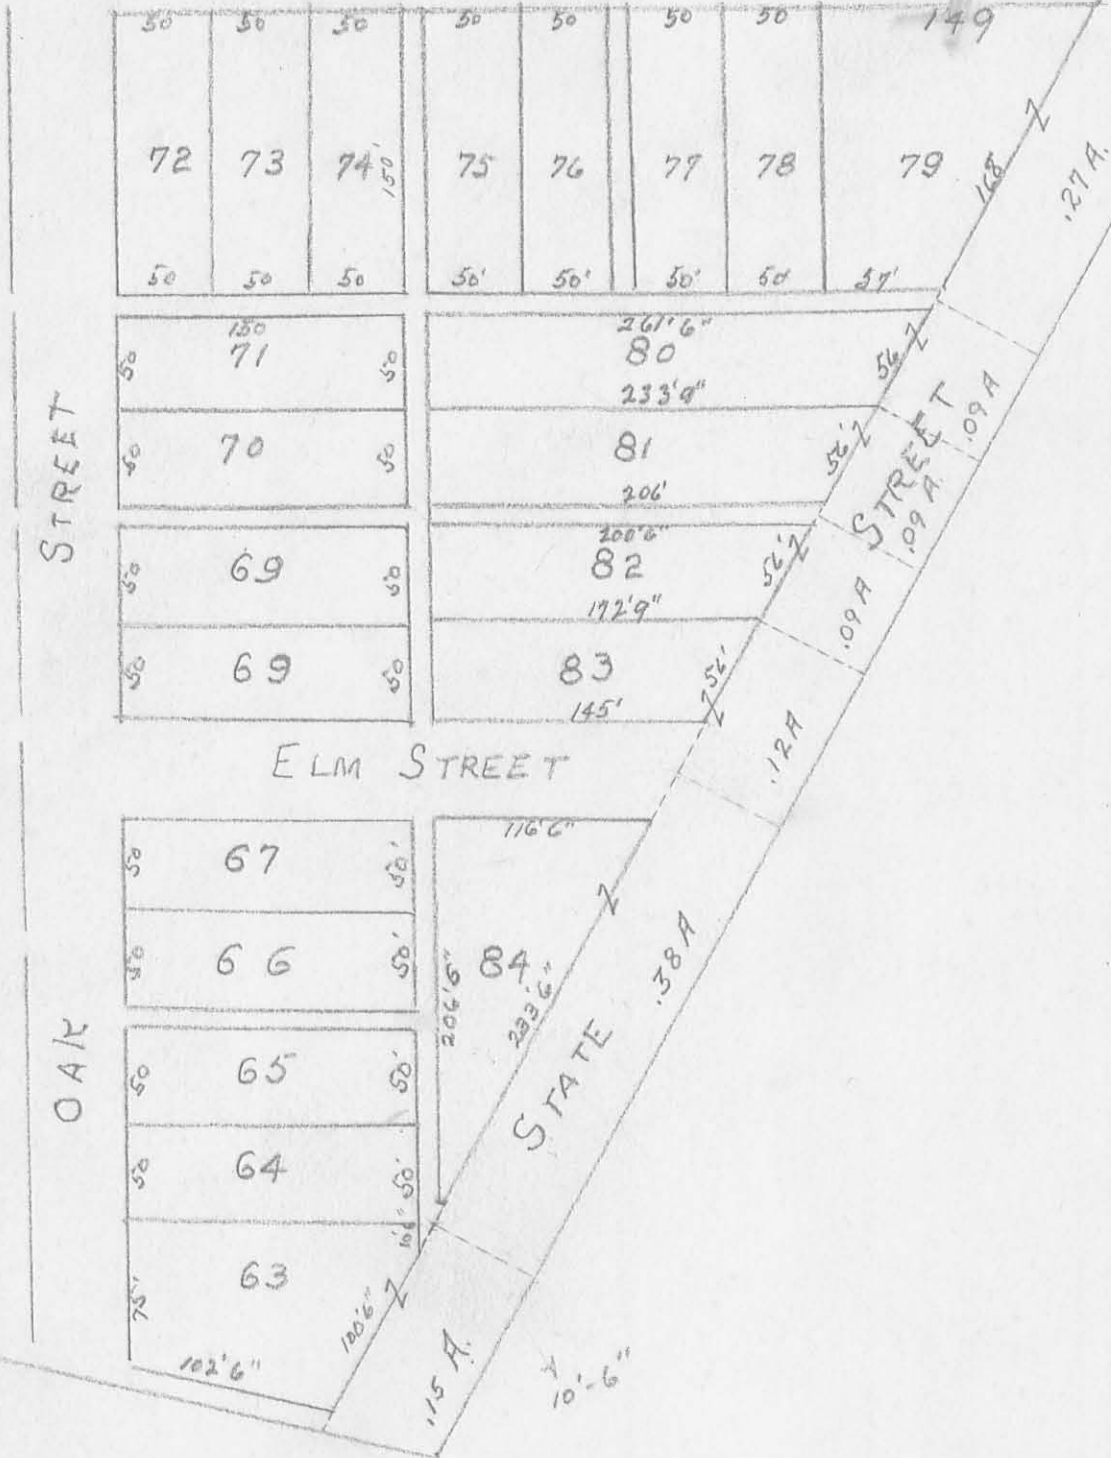

INDEXED ON MAP
1993 IP

Stephenson St.

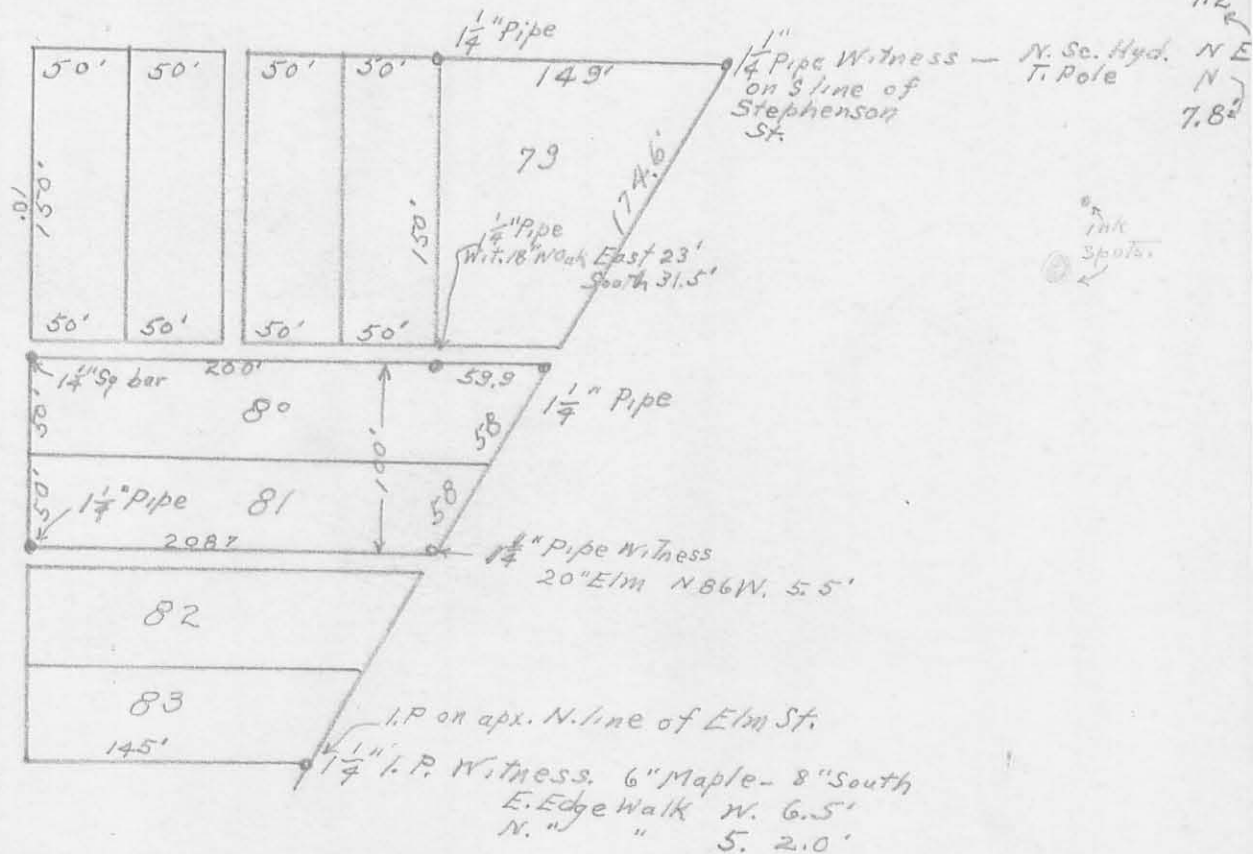

Survey by E. H. Newell

INDEXED ON MAP
1993 2P

State Street (Vacated)
Description

November 18, 1970

The following described real estate situated in the Village of Lakeview, Township of Stokes, County of Logan, State of Ohio and being in Section 27, T.6 S., R.8 E. and being a part of that portion of State Street (Vacated) adjacent to Lots 79, 80 and 81 of Stephenson's Addition to the Village of Lakeview, and being more particularly described as follows:

Beginning at the northeast corner of Lot No. 79 and in the south line of Stephenson Street and the west line of State Street (Vacated);

Thence with the south line of Stephenson Street, N. 61° 11' E. 69.15 feet to a point in the Corporation Line of Lakeview, also being on the west bank of Houchins Slough Ditch;

Thence with said Corporation Line, S. 1° 00' W. 339.84 feet to a point;

Thence N. 89° 00' W. 60.0 feet to a point in the center of a 10 foot alley between Lot No. 81 and Lot No. 82 and in the west line of State Street (Vacated);

Thence with the west line of State Street (Vacated) and the east line of Lots 81, 80 and 79, N. 1° 00' E. 305.45 feet to the place of beginning, containing 19,359.00 square feet or 0.44 Acres, more or less.

I hereby certify that this is a true and accurate description as prepared by me on November 18, 1970.

Daniel E. Gilbert
Daniel E. Gilbert, P.S.
Reg. Sur. No. 5402
428 N. Madriver St.
Bellefontaine, Ohio 43311

