

C.A. Murray Jones
Jim Shroyer

May 3, 1937
May 4, 1937

Survey for Farmer's
Lake View

cas 10-18
143
150352

98.0
21.9
58.0
34.4
107.3

See Co Surveyor's Field Ex 417
" print by Wright
" revised 9-32

- A Found iron pipe 2"
- B " Bolt
- C " iron pipe
- D Set 3/4" x 24" iron pipe
- E " 3/4" x 24" iron pipe
- F " 3/4" x 24" iron pipe
- G Found iron pipe
- H Found iron pipe
- I Found iron pipe
- J Set iron pipe
- K Found old stake and tack
- L " iron pipe
- M " iron pipe
- N " iron pipe
- O " iron pipe
- P " iron pipe
- Q Set iron pipe
- R Found iron pipe
- S " iron pipe 0.6' S. of line
- T Set iron pipe
- U Set iron pipe

11.4
21.9
30
14.3
15.7
1
15.8'

121.5
16
130.2
227.2

62.18 256273
225.509 992243
257030
13.07
107.18 256273

205.5-09 950552
1.210129
162
205 10-18 992243
109 13 977111

12.2 1008977
109 13 977111
109 13 977111


109 13 977111
109 13 977111
151-200

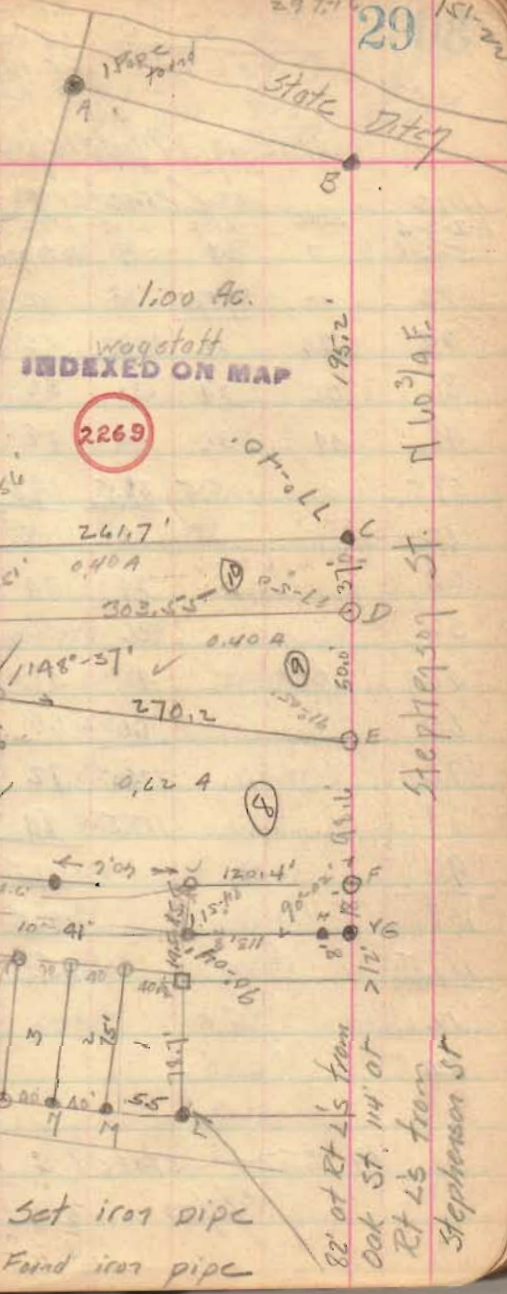

V - Set iron pipe
W - Found iron pipe