

METCALF SURVEY
 SEC. 27, T-6S., R-8E.
 LALEVIEW, OHIO
 SEPT. 8, 1965
 SCALE 1"=30'

3886 IP

INSERTED ON MAP

Dan L. Dodson
 Dan L. Dodson
 Reg. Surveyor 4270
 Bellefontaine, Ohio

o = Pipe Found

ON PLAT BOOK
 2-3-66
 DEG.


HAINES SURVEY
LAKEYLEY, OHIO

- A = 1/2" Pipe Found
- B = 1/2" Pipe Found
- C = 3/4" Pipe Found
- D = 1/2" Pipe Found
- E = 3/4" Pipe Found
- F = 3/4" Pipe Found
- G = 3/4" Pipe Found
- H = 1/2" Pipe Found
- I = 3/4" Pipe Found
- J = 1/2" Pipe Found

INDEXED ON MAP
3886

Whitlow
Artis

Dec. 1967 62

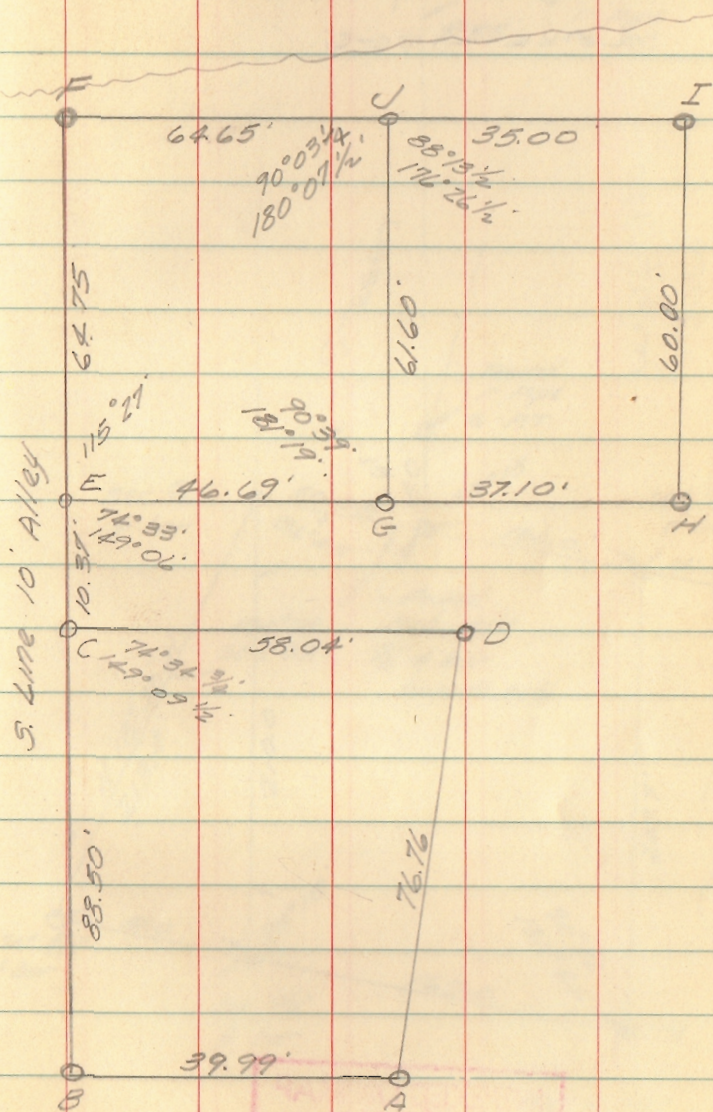

INDEXED ON MAP
3886

METCALF SURVEY

OAK ST.

LAKEVIEW, OHIO

- A = $\frac{1}{2}$ " pipe at E. edge of walk found
 B = $\frac{3}{4}$ " " found
 C = $\frac{1}{2}$ " pipe found
 D = " " "
 E = $\frac{1}{2}$ " pipe found at E. edge of walk
 F = $\frac{1}{2}$ " pipe found " "
 chiselo mark on walk
 G = $\frac{3}{4}$ " pipe found
 H = $\frac{1}{2}$ " pipe found

INDEXED ON MAP

3886

Dutton
Geeslin

Sept. 8, 1965

32

