


UNION STREET
 VILLAGE: LAKEVIEW
 TOWNSHIP: STOKES
 COUNTY: LOGAN
 STATE: OHIO

CITY LOTS: 371 & 372
 PLAT NAME: NICHALSON FAIR VIEW AD.
 PLAT LOTS: 371 & 372
 PLAT BOOK: B Vol. 2
 PAGE: 33

Survey made for & at the instance of:
 TRU-VAL HOMES, INC.

I certify that this survey shows the improvements as located on the premises described; that the improvements are entirely within lot lines & that there are no encroachments upon the premises described by the improvements of adjoining premises.

Owens K. Shirk
 Reg. Surveyor 4271

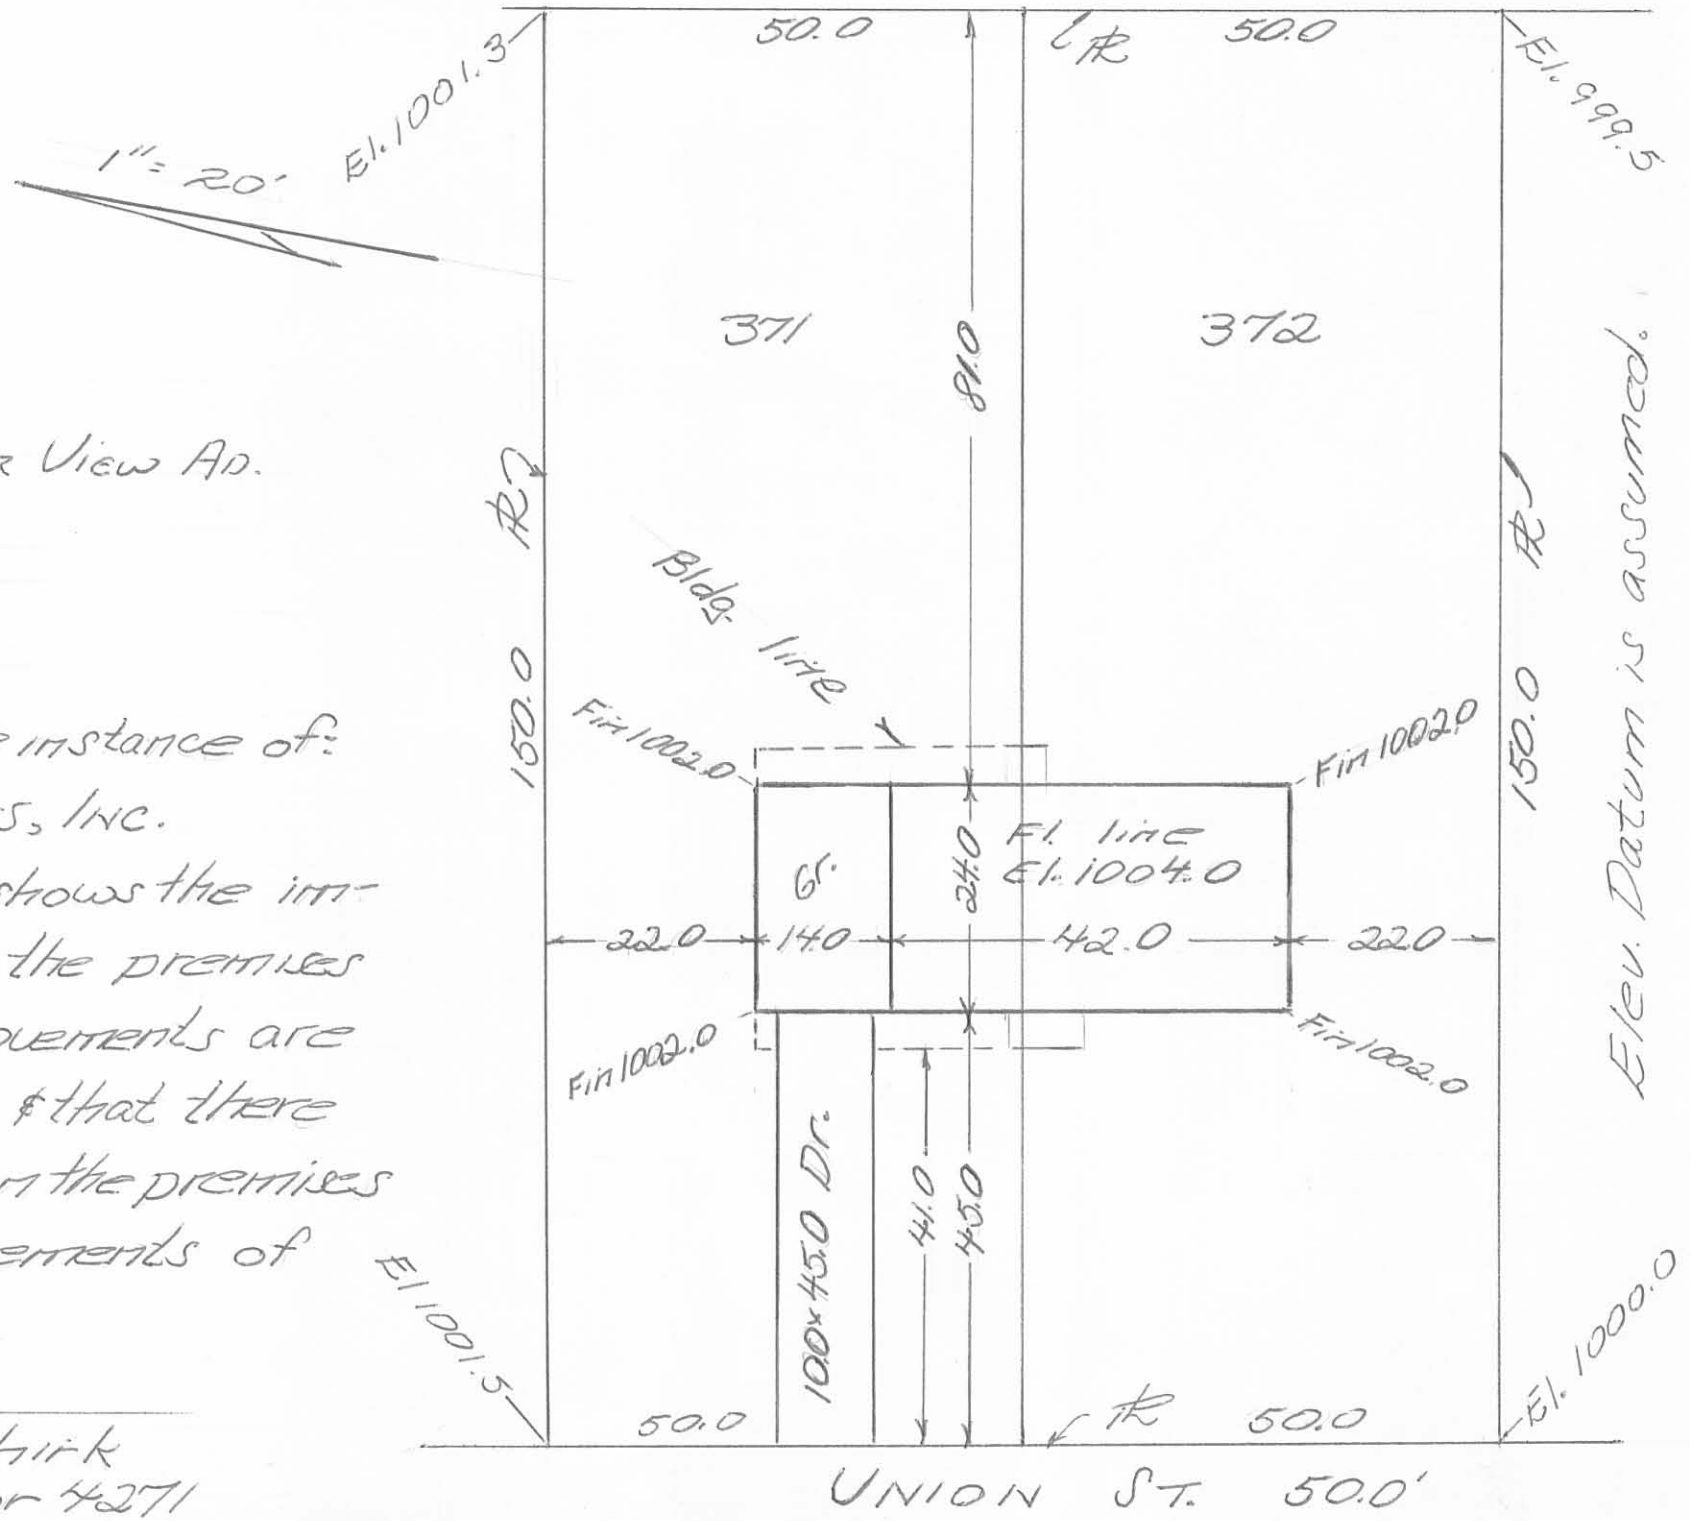

Elev. Datum is assumed.

6145 VP

INDEXED ON MAP