


Received 7-8-85



BENTZ AVENUE - 30'

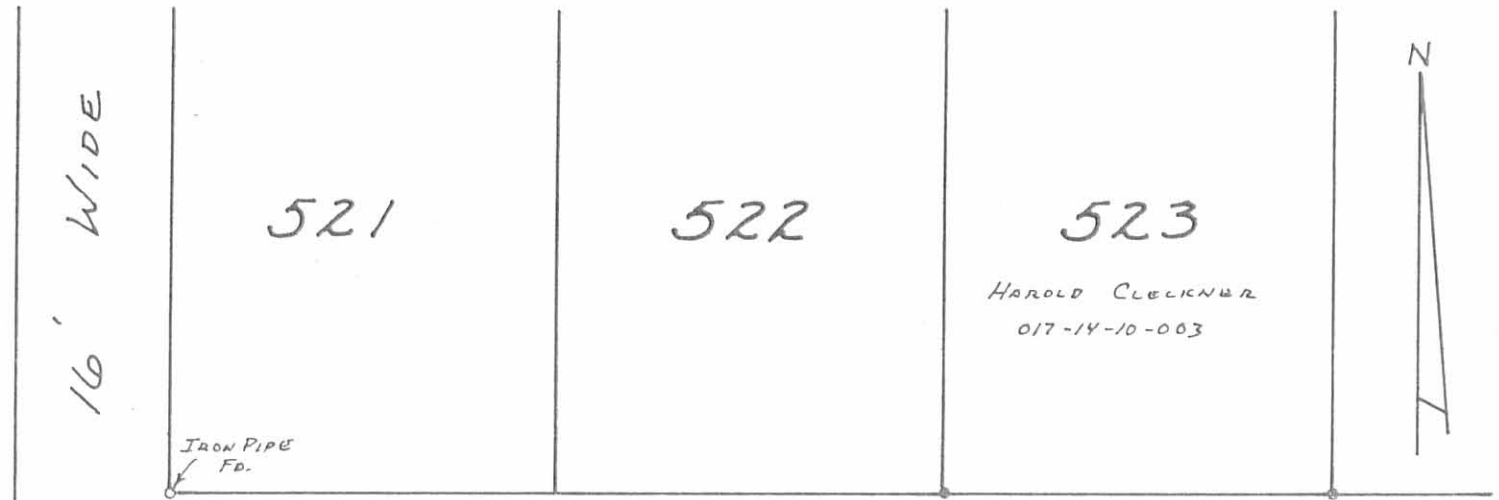

● - 5/8" Ø REBARS FD. OR SET.

INDEXED ON MAP
7400 IP

Daniel E. Gilbert

SURVEYED AND PLATED BY:
DANIEL E. GILBERT, P.S.
REG. SUR. NO. 5402
105 ORGAN ST.
BELLEFONTAINE, OHIO 43311



CLECKNER SURVEY
LOT NO. 519
VILLAGE OF LAKEVIEW
STOKES TOWNSHIP
LOGAN COUNTY, OHIO
JUNE 21, 1985

SCALE: 1" = 20'

085-015