




CHURCH LOT  
VOL. 71 PG. 550

BROWN ST.  
30'

MAIN STREET 60'

14' PUBLIC ALLEY

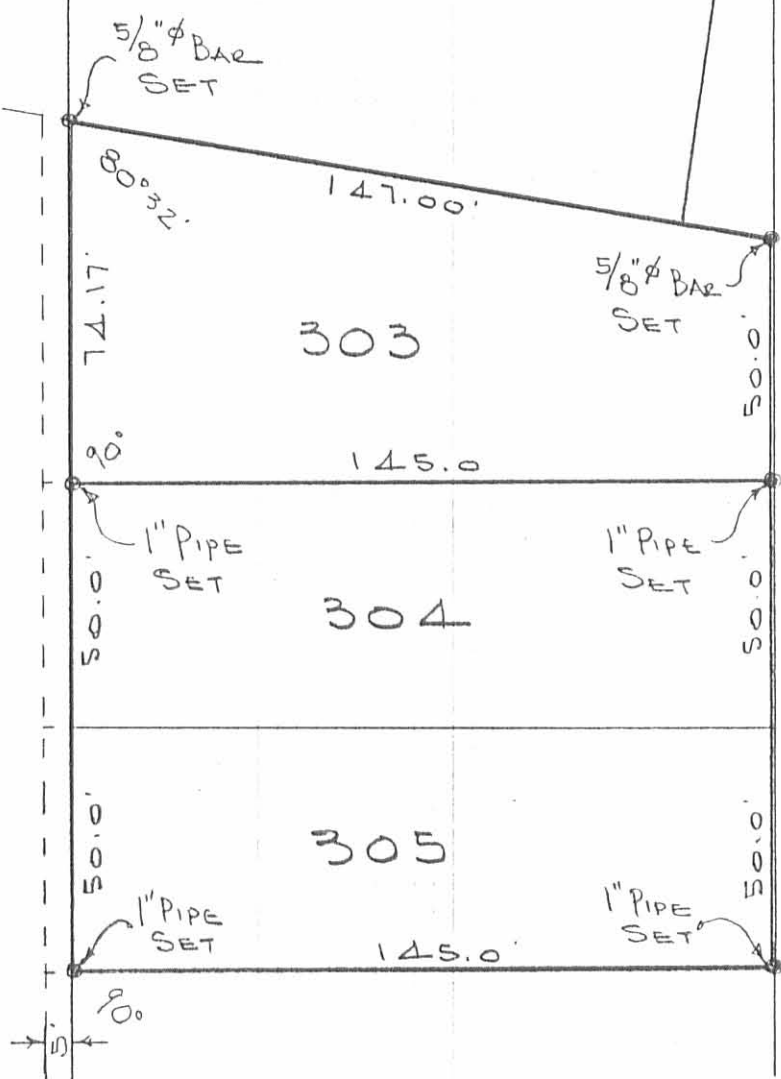

INDEXED ON MAP  
79831P

SURVEY OF  
LOTS 303-304-305  
LAKEYVIEW, OHIO  
MARCH, 1979  
SCALE 1"=40'

DAN L. DORSON  
REG. SURVEYOR 4270  
BELLEFONTAINE, O.