


PINE ST.

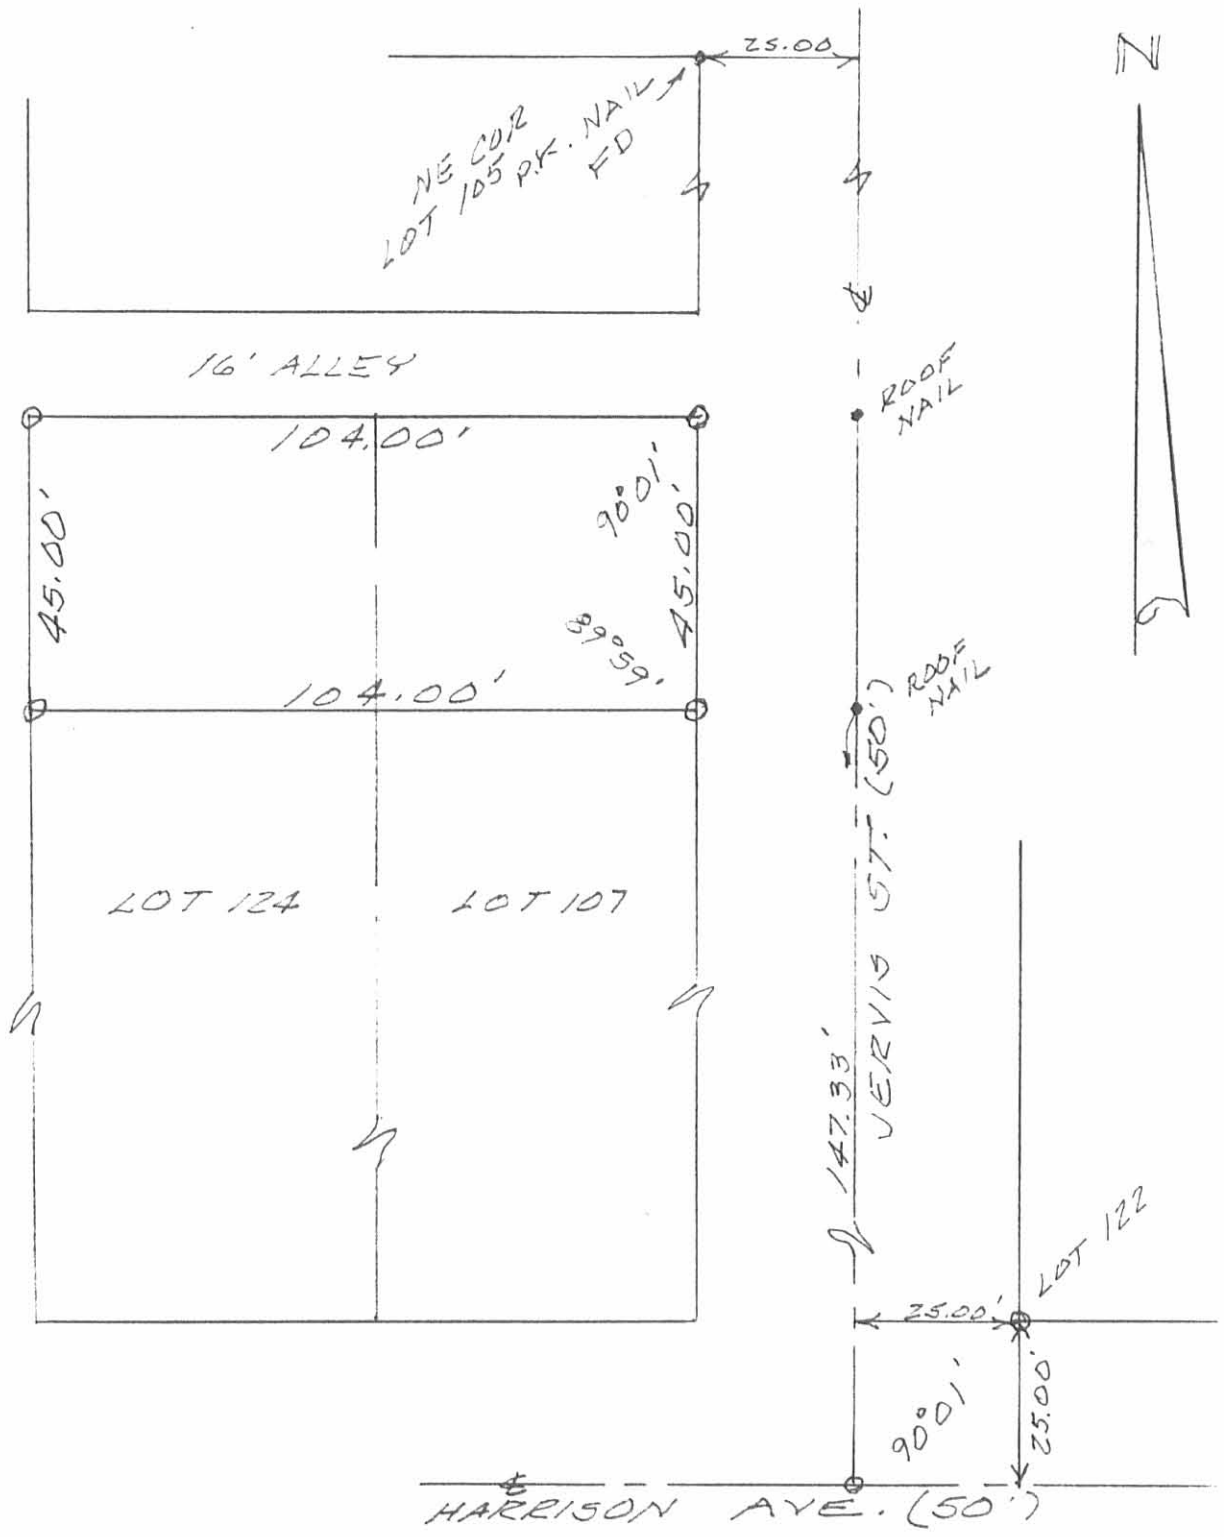

SURVEY OF NORTH 45'
OF LOTS 107 & 124 OF JERVISS
ADDITION TO LAKEVIEW, OHIO
SEPTEMBER 15, 1992
SCALE: 1" = 30'



INDEXED ON MAP
8747 IP

Leslie H. Geeslin
LESLIE H. GEESLIN
RUSHSVLVANIA, OHIO
PH 513-463-2793