



Received 4-11-95 ok gch

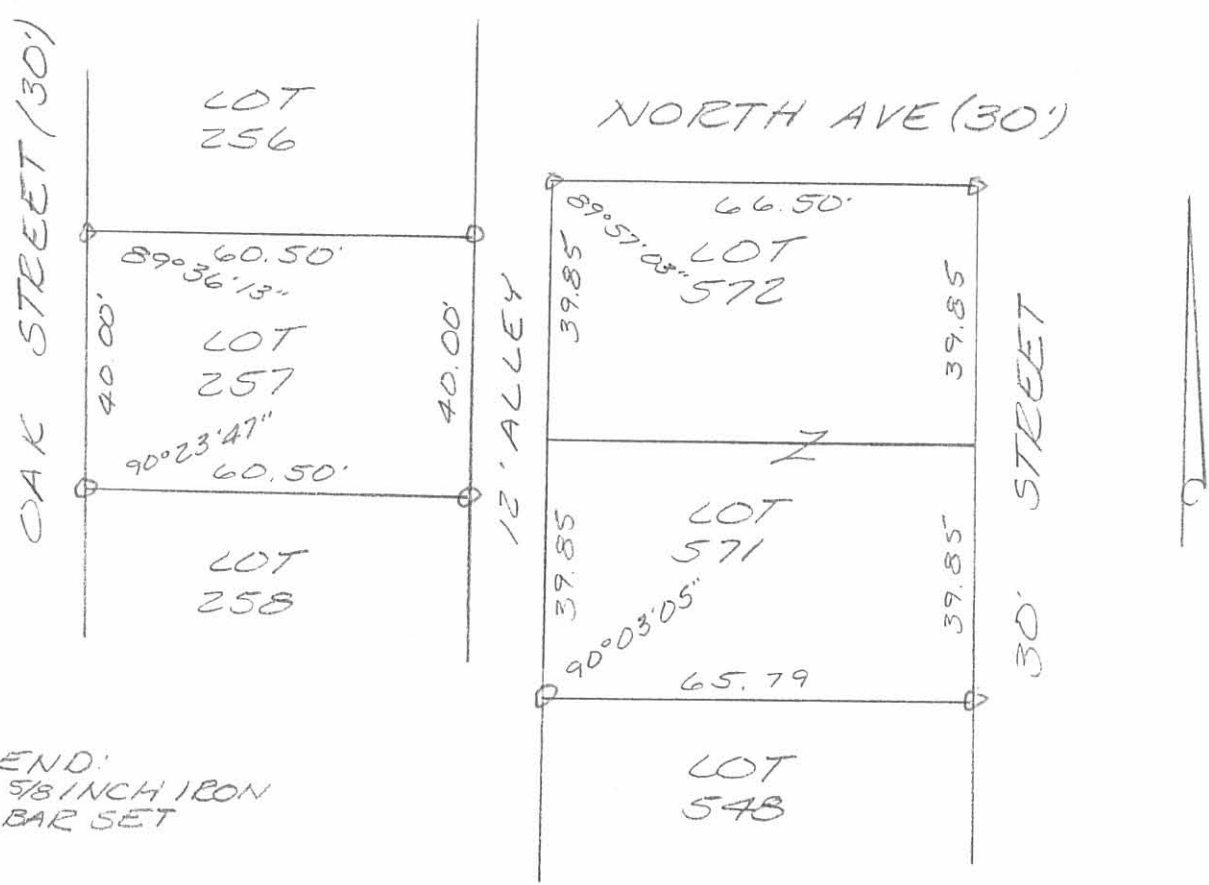

LEGEND:
b = 5/8 INCH IRON BAR SET

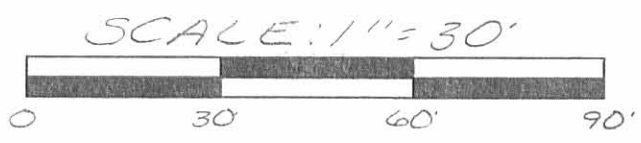

SURVEY OF LOTS 257, 572, AND 571
 IN NICHOLSON'S FIFTH ADDITION
 TO THE VILLAGE OF LAKEVIEW IN
 SECTION 27, TOWN 6 S., RANGE 8 E.,
 STOKES TOWNSHIP, LOGAN
 COUNTY, OHIO For
 WILLIAM CUNNINGHAM
 APRIL 7, 1995



INDEXED ON MAP
 9000 IP

Leslie H. Geeslin
 LESLIE H. GEESLIN
 RUSHSVLVANIA, O
 (513) 468-2793