


RCD 4-24-07 SMM OK

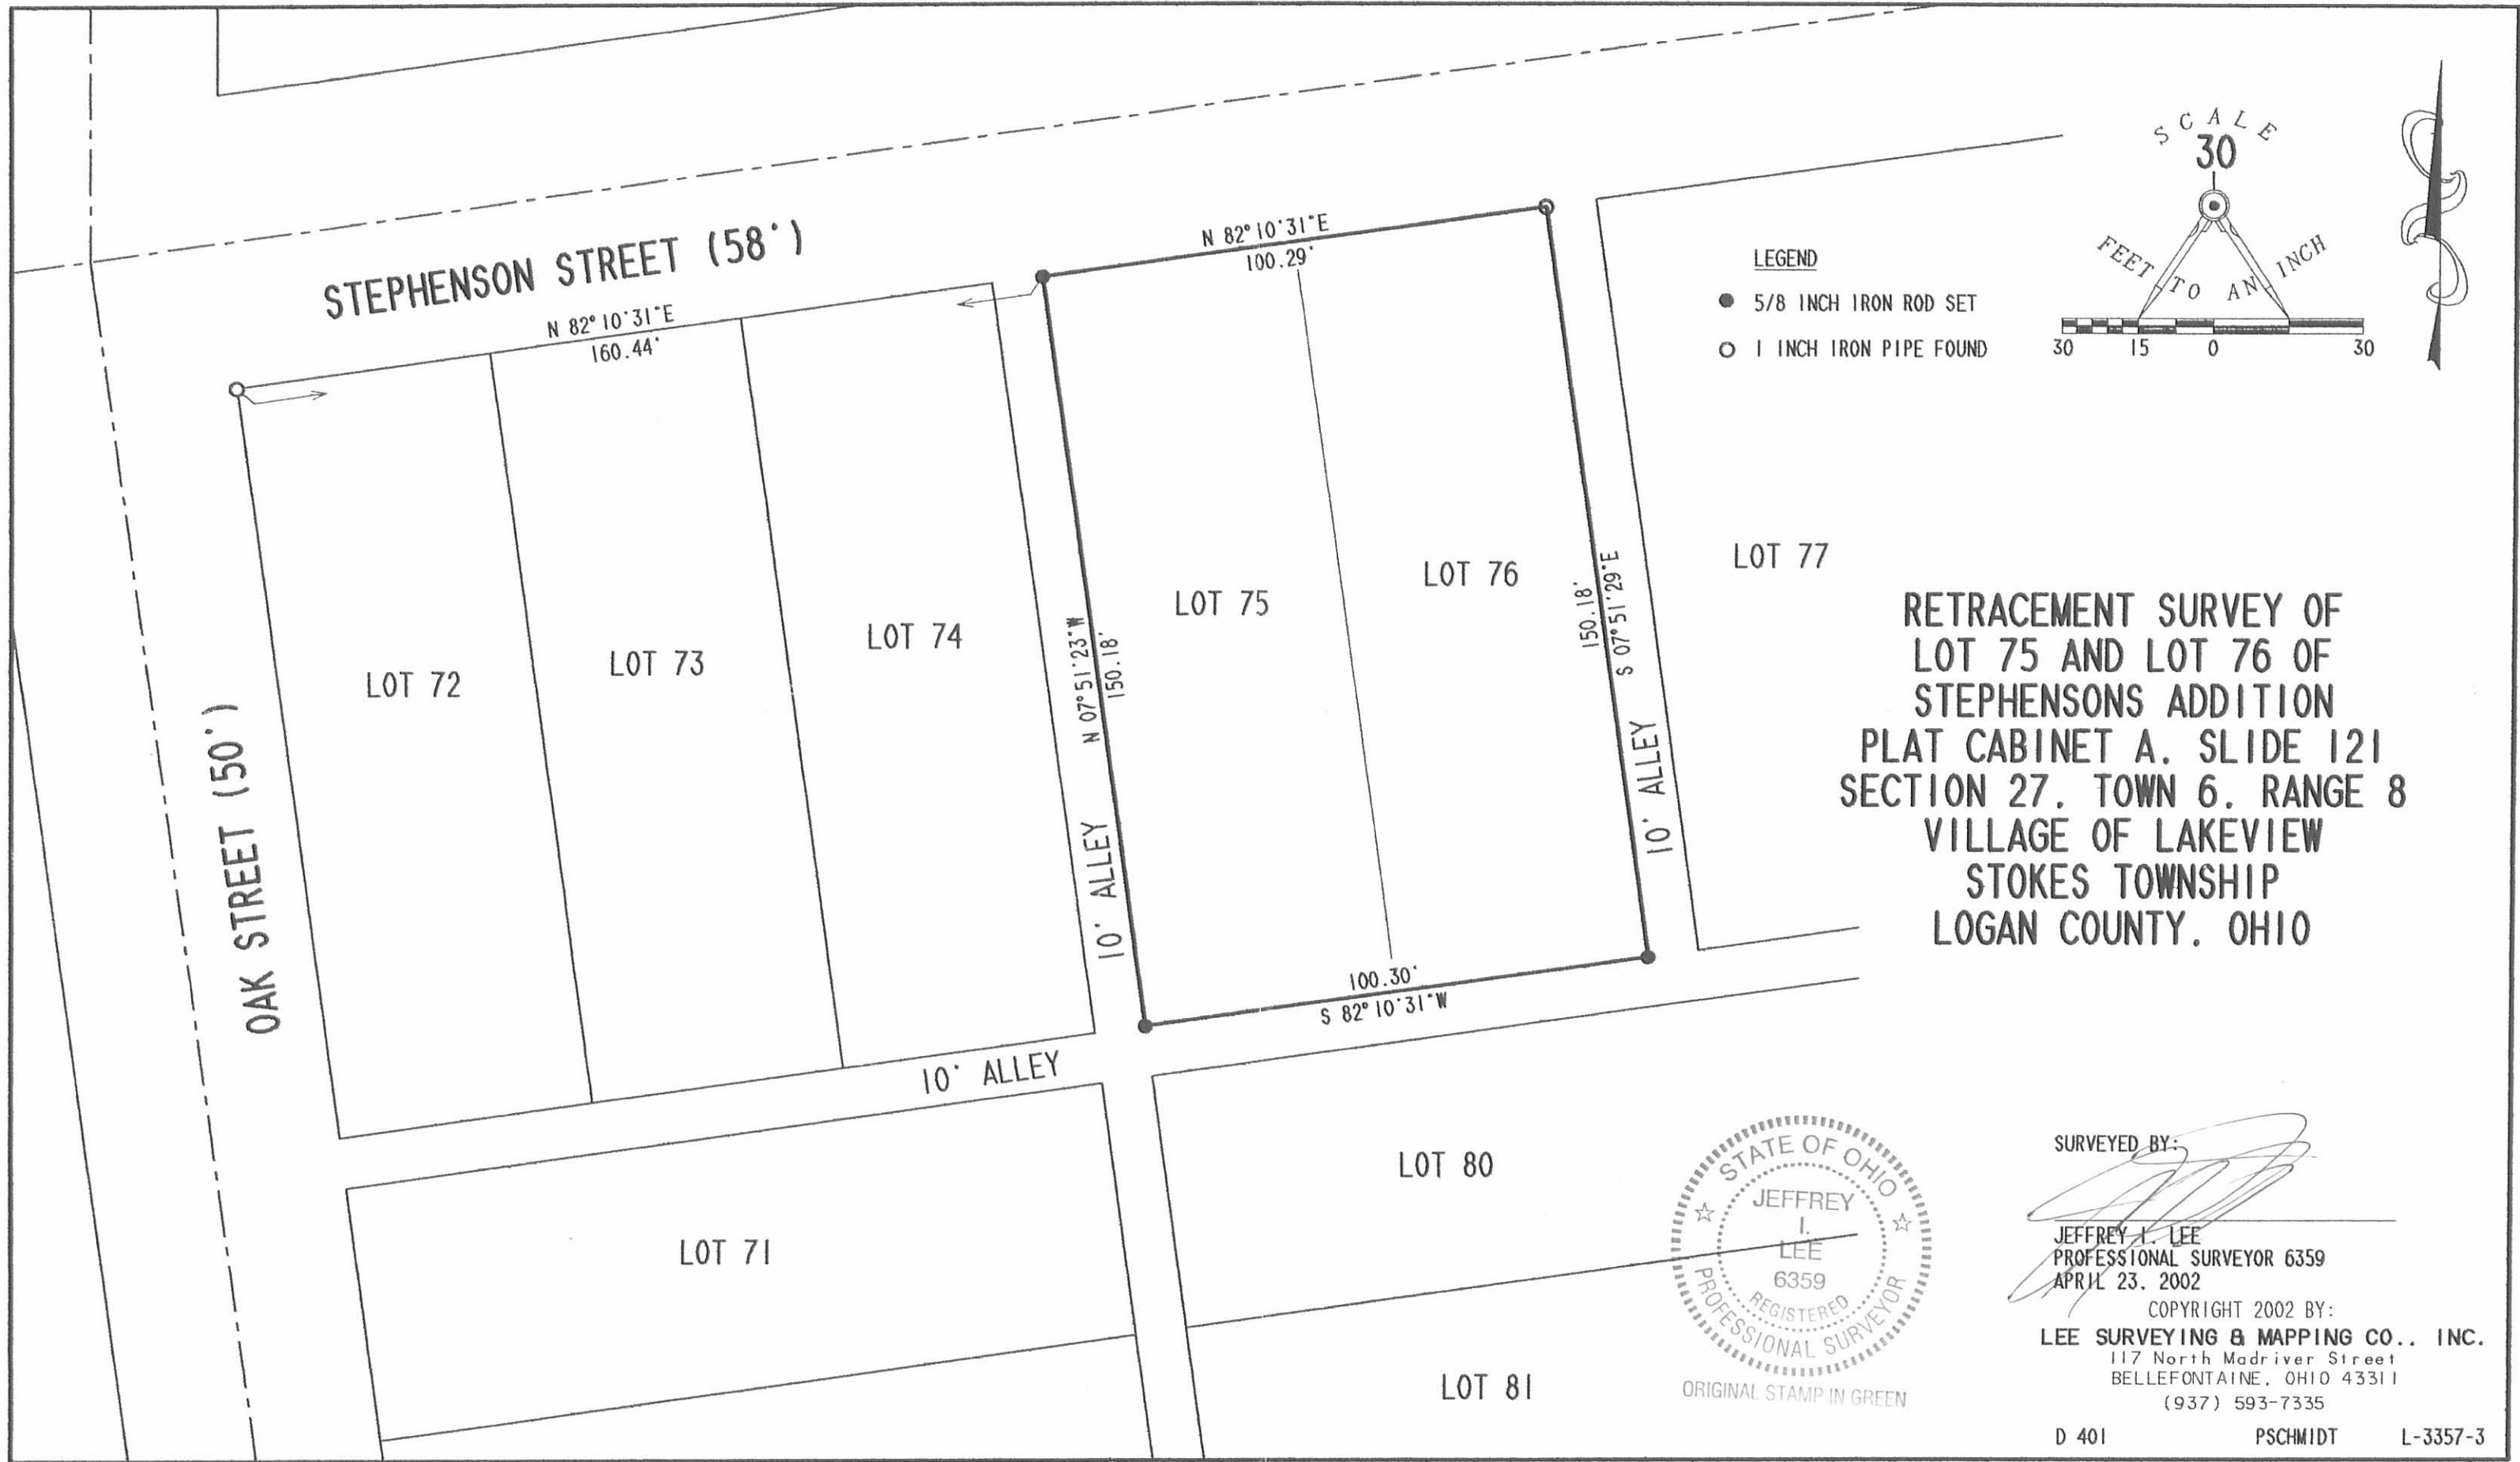

**RETRACEMENT SURVEY OF  
 LOT 75 AND LOT 76 OF  
 STEPHENSONS ADDITION  
 PLAT CABINET A. SLIDE 121  
 SECTION 27, TOWN 6, RANGE 8  
 VILLAGE OF LAKEVIEW  
 STOKES TOWNSHIP  
 LOGAN COUNTY, OHIO**



ORIGINAL STAMP IN GREEN

SURVEYED BY:  
  
 JEFFREY I. LEE  
 PROFESSIONAL SURVEYOR 6359  
 APRIL 23, 2002

COPYRIGHT 2002 BY:  
**LEE SURVEYING & MAPPING CO., INC.**  
 117 North Madriver Street  
 BELLEFONTAINE, OHIO 43311  
 (937) 593-7335

D 401 PSCHMIDT L-3357-3

INDEXED ON MAP  
 9405 1P