


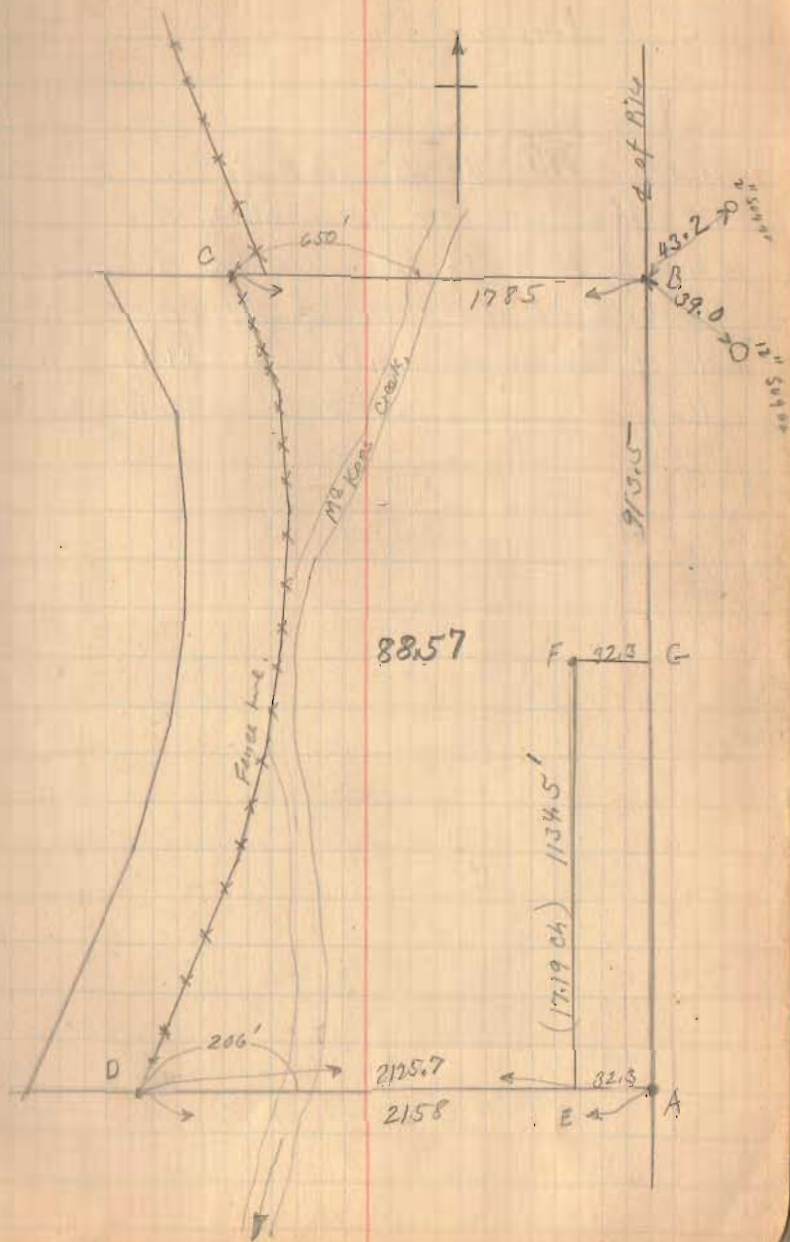

Irish Survey Continued

8857 Acres BCD EFG

Distances same as on page 27. Area AGFE not included in acres. See Note page 29.




Irish Survey

Note old deeds platted (Not to scale)  
 To show part of farm which does  
 not go to  $\frac{1}{4}$  of Pike. Stone not  
 found. Used distance of 49 pks from  
 $\frac{1}{4}$  of Pike and 17.19 (16.08 + 1.11) chains  
 long as not counted in new survey.

6-27-27

29

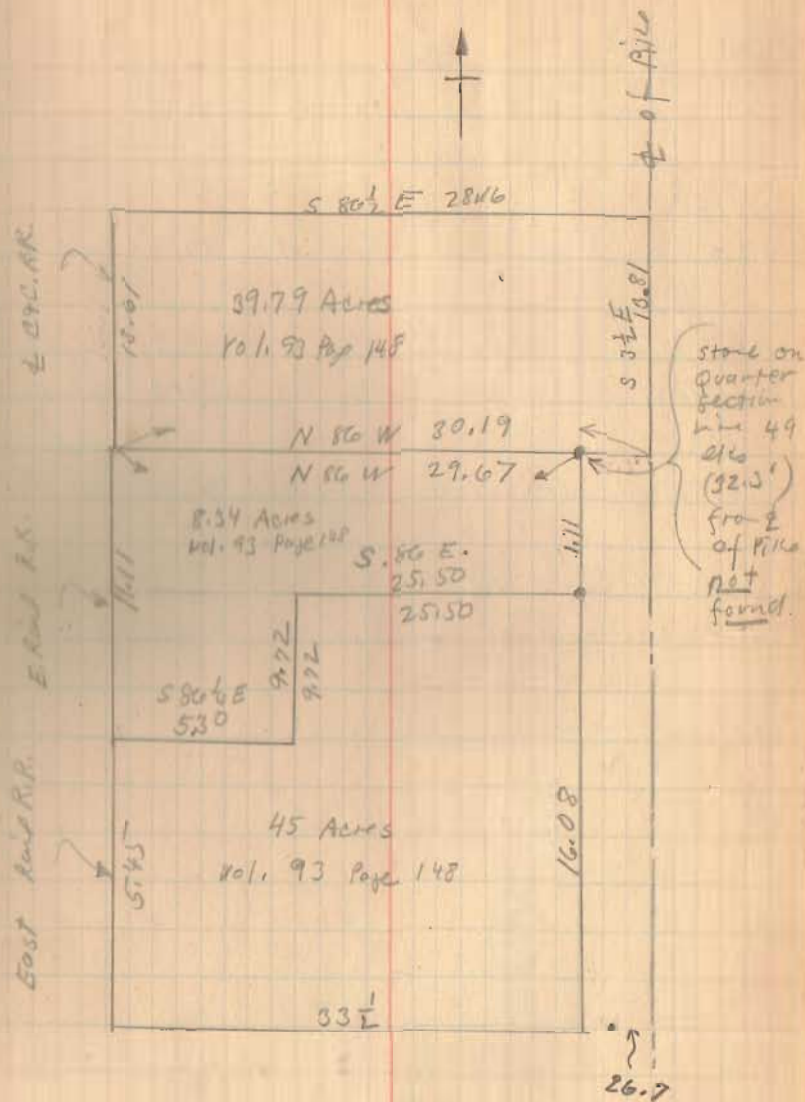

Irick Survey

The following described land in Section 31, Town 4, Range 14, of the Miami River Survey, and being in Liberty Township, Logan County, Ohio.

<sup>Fence</sup> Beginning at an iron in the center of the Bellefontaine and West Liberty state pike, thence N. 86° 23' W. with the South line of Startzman's 37 acre tract 1785 feet to an iron in the East Right-of-way fence line of the I.C. & E. Elec. R.R., said iron being 25 feet from the center of said R.R. track, thence with said line S. 1° 33' W. 398 feet; S. 3° - 24' W. 200.8 feet; S. 5° - 28' W. 200.8 feet; S. 7° - 15' W. 200.8 feet; S. 9° - 21' W. 200.8 feet; S. 10° - 09' W. 800.4 feet to an iron in said East Right-of-way fence line and 25 feet from center line of track; thence S. 85° - 21' E. with the north line of Ford's 57 acre tract 2157.7 feet to a point 32.3 feet West of the center of the West Liberty pike; thence N. 3° - 30' W. 1134.5 feet to a point in the South line of the N. E. quarter of said section 31; thence S. 85° - 21' E. 32.3 feet to the center of the West Liberty pike; thence N. 3° - 30' W. with the center of the West Liberty Pike 913.5 feet to the place of beginning said tract containing eighty-eight and fifty-seven hundredths ( 88.57 ) acres more or less and being the same tract as surveyed June 27, 1927 and being shown and recorded in Logan County Surveyor's Field Book # 419 Page 27.

637 ID

INDEXED ON MAP