


929

Pt. S.W. qr. Sec. 27-5-13

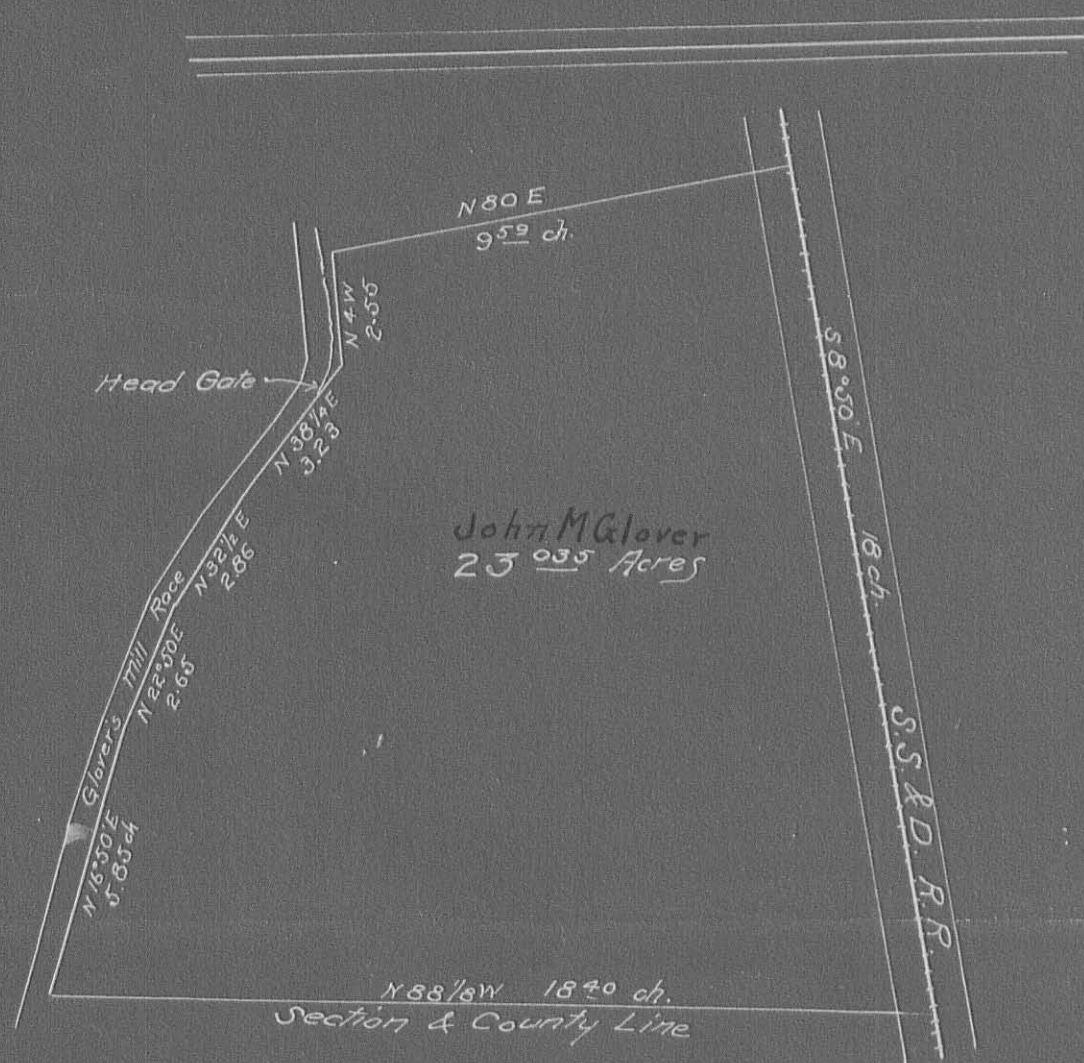

Surv. Record "C" p. 27
by H.C. Moore, Sept. 1859.