

Road 160^{9/11} 161 Zone Twp


60' Vol. 6 Page 132 } 1840
Vol. 6 Page 216 }
161^{9nd} Part of 160
Co. Line North To old
road. Dist 1.600 Miles

60' Road staked 20' from &
for a 40' road.

(419)

INDEXED ON MAP


Aug. 26, 1922
Shonck
Wright
Ritz

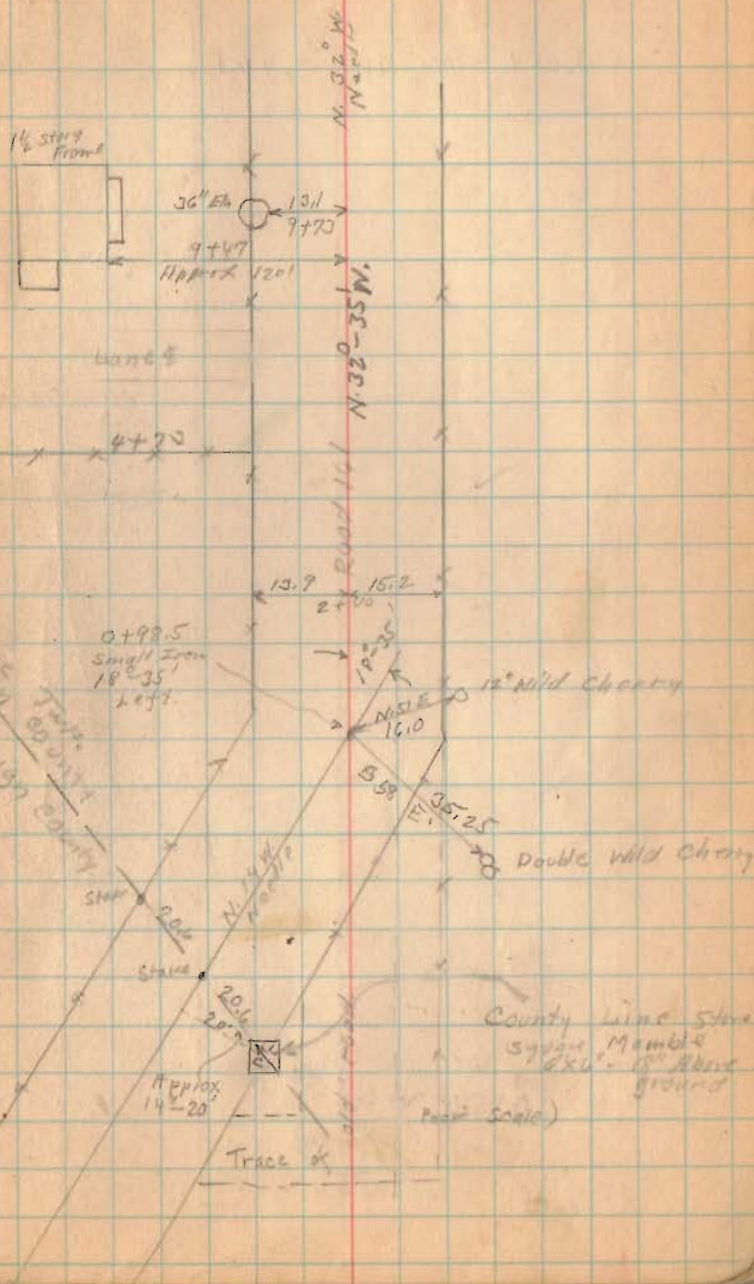

Road No 160 ^{also} 161



H. W. Jones

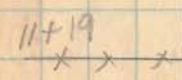

T. B. Washimer

Road No 161

1419.

INDEXED ON MAP

Road No. 160 $\frac{E}{W}$ 161


Aug. 29, 1932

Nice day

W. L. J. H. T.

Mr. K. R. B. H. V.


41

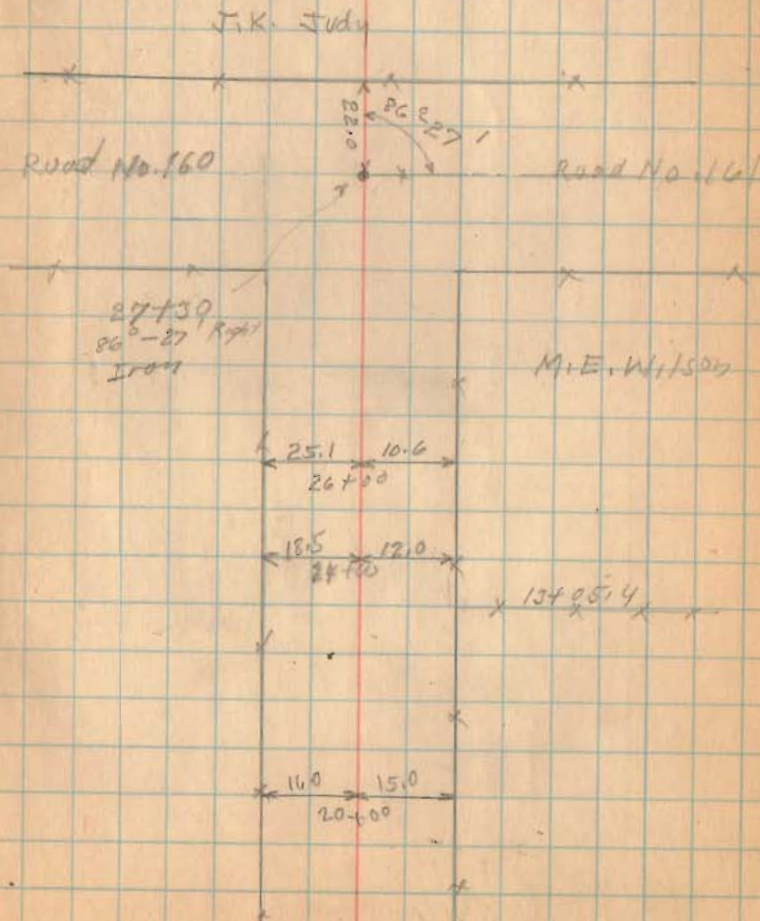

1419

INDEXED ON MAP

Road No. 160 9/2/16

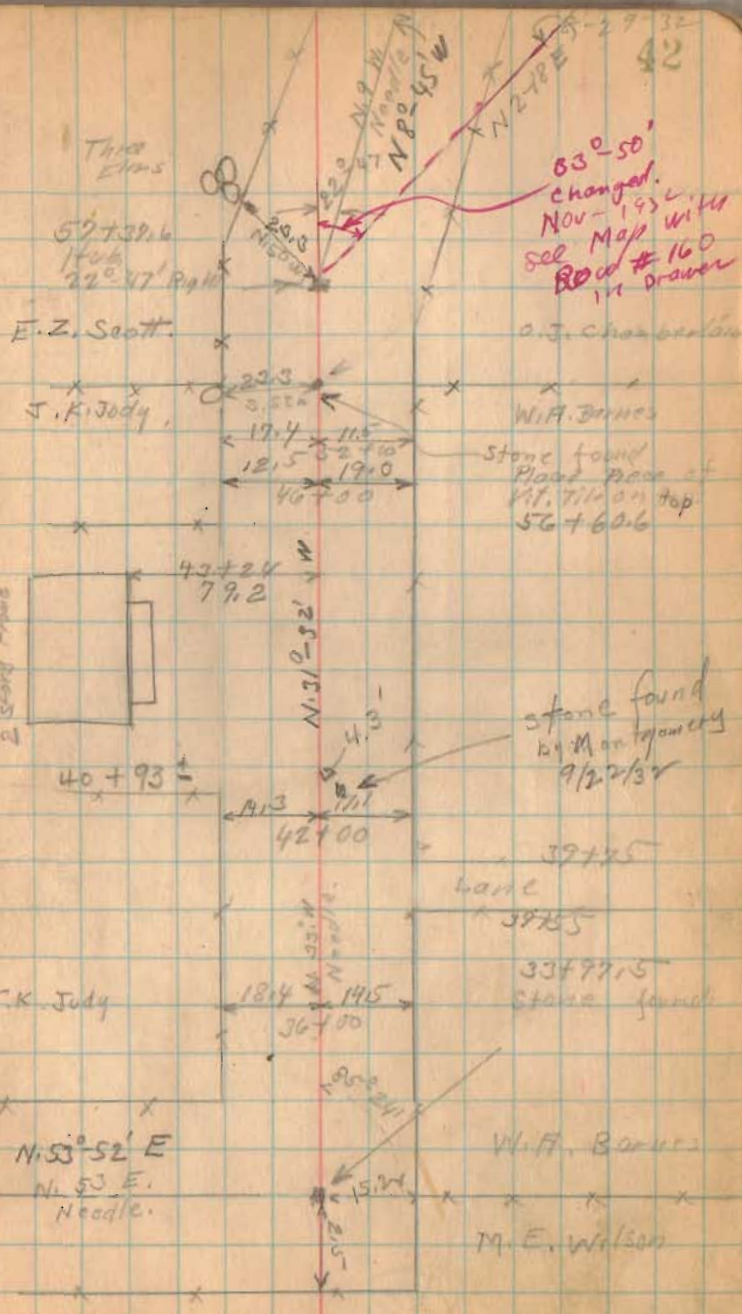

(1419)

INDEXED ON MAP

Road 100 E 161

(1419)
INDEXED ON MAP

8-27-31

43

