



(16)

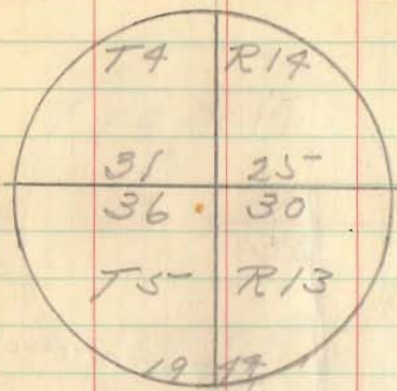

10-13-44  
 Dyserf  
 Dickinson  
 B. Wilgus

Found Stone. Removed same  
 and placed Corn Man. Full length  
 See Field Book 498 p 5 & 11  
 Top 9" below surface of road  
 Marked as above

39

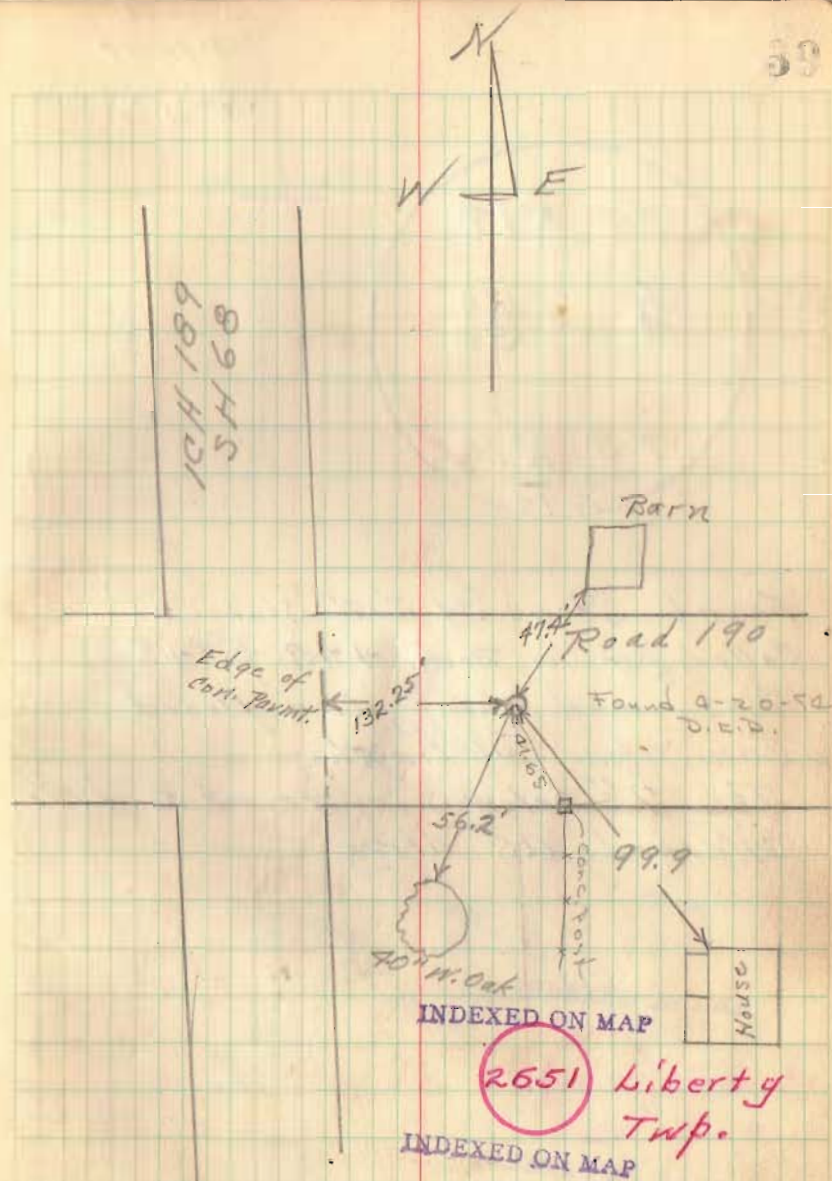

INDEXED ON MAP

2651 Liberty  
 Twp.

INDEXED ON MAP