

Mc Alexander - Davie Survey Liberty Township November 1964 6.95 Acres

The following described land in Liberty Township, Logan County, Ohio. and being in Section 32 Town 4 Range 14.

Beginning in the center of U.S.Route Number 68 known as the West Liberty Bellefontaine Road and said beginning point being in the north line of said section 32 which is also the center line of County Highway Number 200.

Thence with the center of U.S.Route Number 68 S. 4° - 10' E. 339.90 feet.

Thence with the south line of a 11.00 acre tract now in the name of Carl Davie which is also the north line of a 9.45 acre tract now in the name of Laurel McAlexander N. 86° - 05' W. 300.00 feet to an iron said iron being the true beginnin point of this survey.

Thence S. 4° - 10' E. 471.20 feet to an iron in the north line of a 73.72 acre tract now in the name of Erenest Flax. and said iron also being the S.W. corner of a 0.68 acre tract now in the name of Helen Wilson.

Thence with the north line of said Flax 73.72 acre tract N. 85° - 39' W. 675.35 feet.

Thence N. 1° - 10' E. 461.35 feet.

Thence S. 86° - 05' E. 631.25 feet to the place of beginning.


The above described tract contains 6.95 acres and being out of the south siad of a 9.45 acre tract now in the name of Laurel McAlexander.

cc
Logan County Engineer



3737 ID

INDEXED ON MAP. R

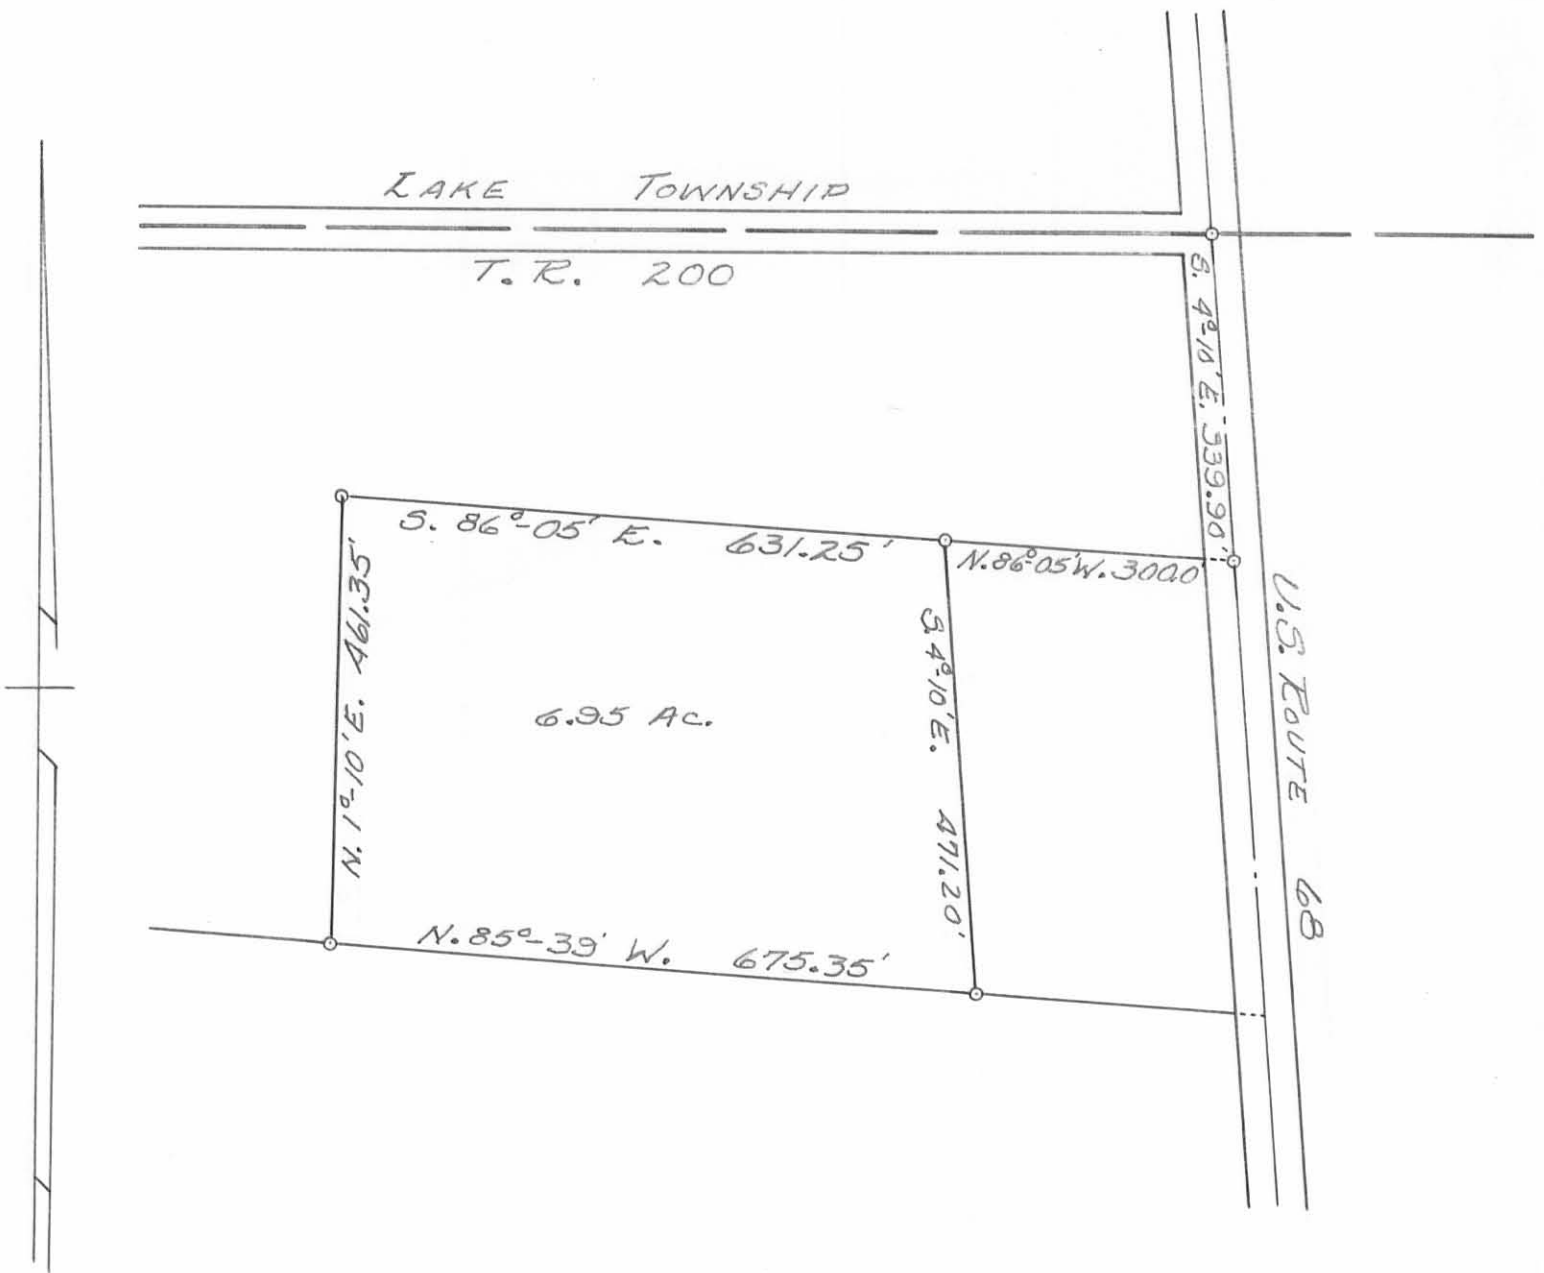

M^cALEXANDER - DAVIE SURVEY
 SECTION 32 - TOWN 4 - RANGE 14
 LIBERTY TOWNSHIP
 LOGAN COUNTY, OHIO
 SURVEYED BY F. F. WRIGHT - 1964
 SCALE: 1" = 200'

3737 1P

DRAWN BY D.E.G.
 12/30/64

INDEXED ON MAP