

C. H. 32  
LIBERTY TOWNSHIP

FB 703

35+72.05  $\frac{1}{2}$ "  $\phi$  Bar Set - Angle =  $31^{\circ}56'$  Lt.

27+27.97  $\phi$  C.H. 249  
Found Stone, Set Iron on top.

25+97.6  $\frac{1}{2}$ "  $\phi$  Bar Set - Angle =  $21^{\circ}39'$  Rt.

10+75.0  $\frac{1}{2}$ "  $\phi$  Bar Set - Angle =  $14^{\circ}13'$  Lt.


0+00  $\frac{1}{2}$ "  $\phi$  Bar Set @  $\phi$  C.H. 30 & 32

B-31-62 *Fig. 10*  
Dodson  
LIRA  
EIGSIT  
RICKATS  
WILLMAN

$\phi$  C.H. 32

INDEXED ON MAP

4323

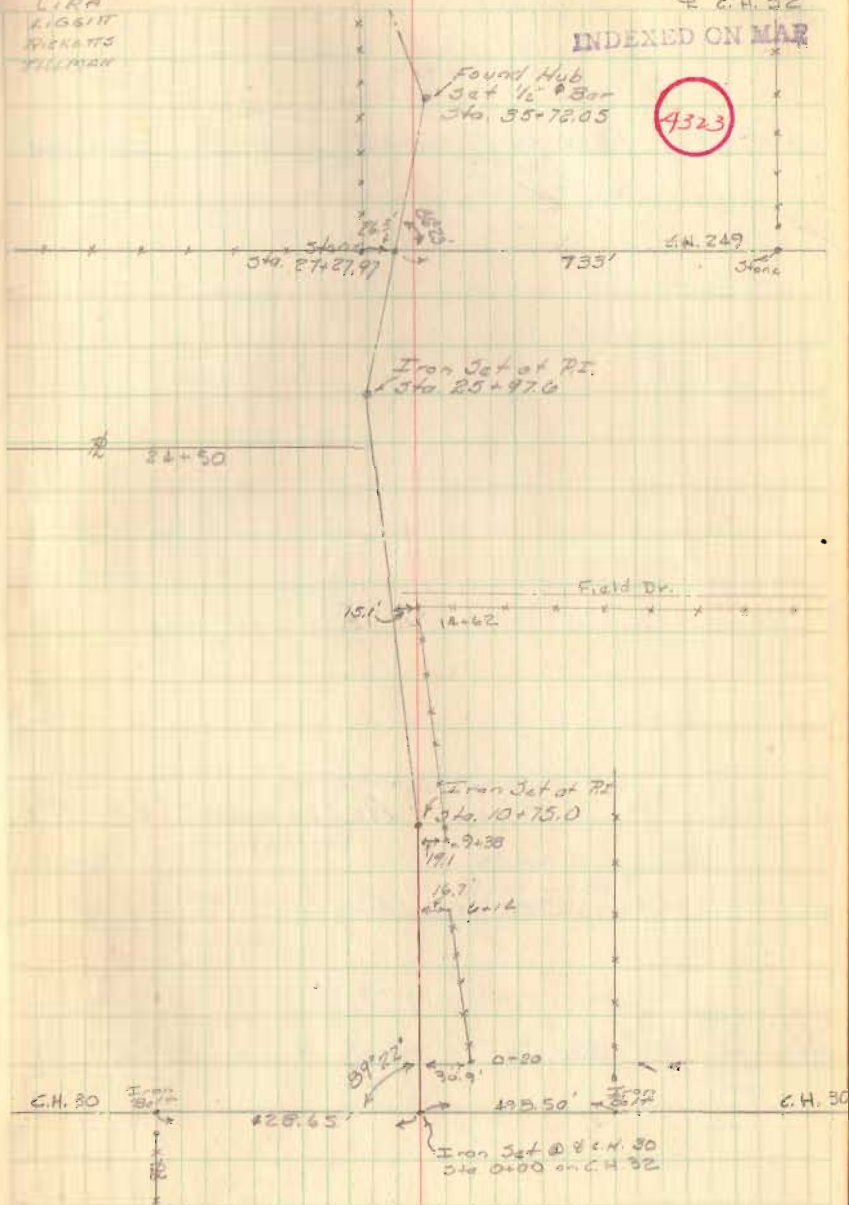

FB 703

C. H. 32


61+90.15 Resurvey Monument with  $\frac{3}{4}$ " pipe set on top.

47+82.19  $\frac{3}{4}$ " Pipe Angle  $108^{\circ}05'$  Rt.

44+83.05  $\frac{1}{2}$ "  $\phi$  Bar Set Angle  $13^{\circ}24'$  Lt.

41+99.16  $\frac{1}{2}$ "  $\phi$  Bar Set - Angle  $66^{\circ}00'$  Lt.

2

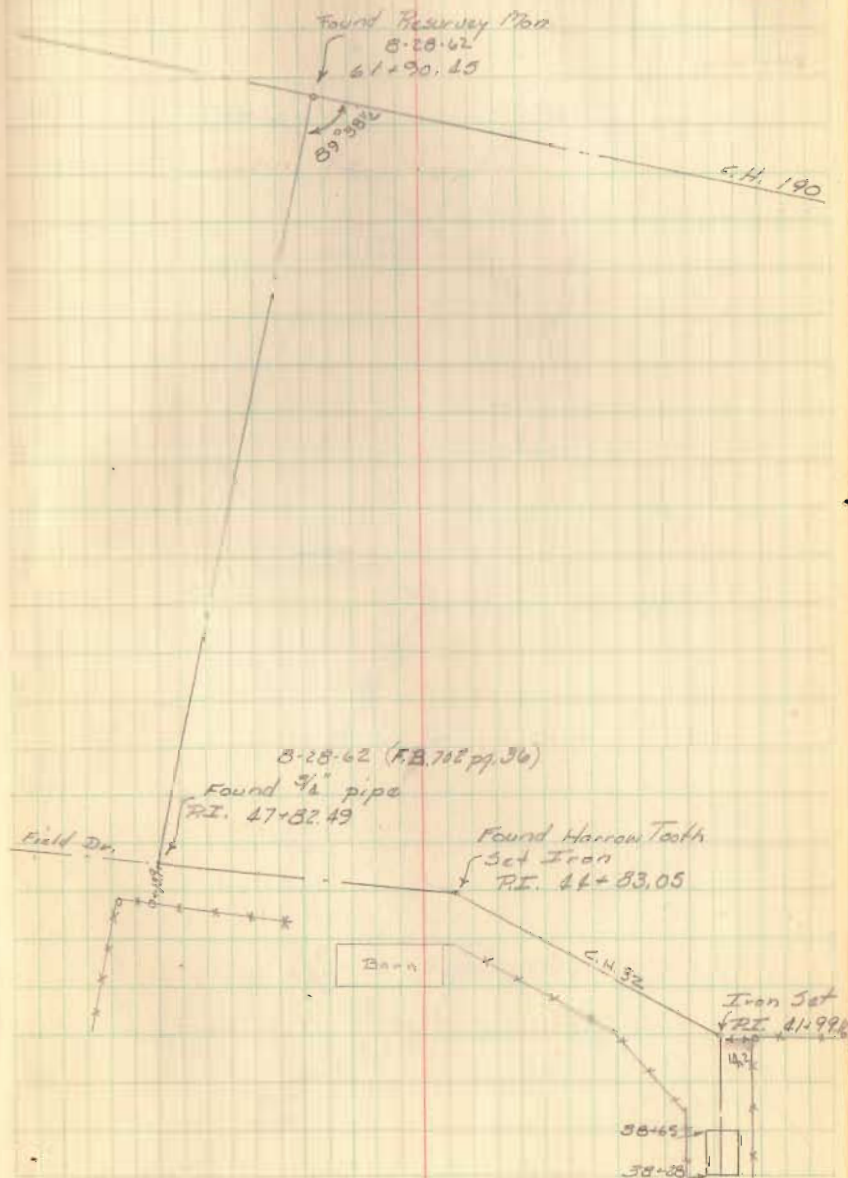

C. H. 32


FB 703

J. CIRA  
G. Gaslin  
10-23-62  
Tool


4 C.H. 32

Witnessed Irons

3

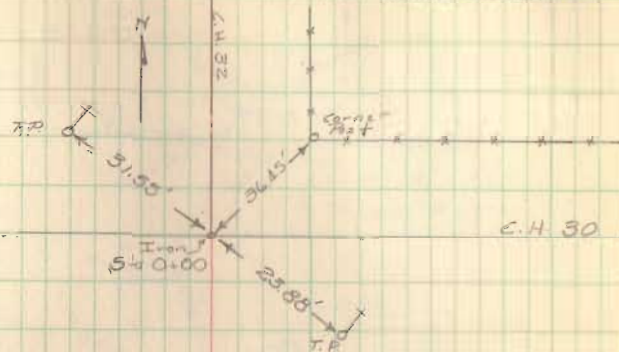





C.H. 30

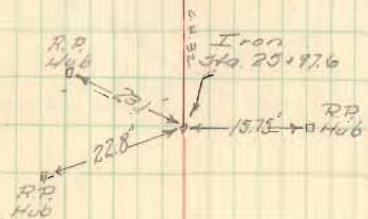

CIRA  
Geeslin

C. H. 32



FB 703

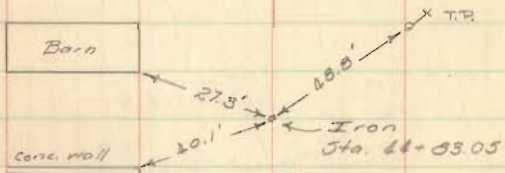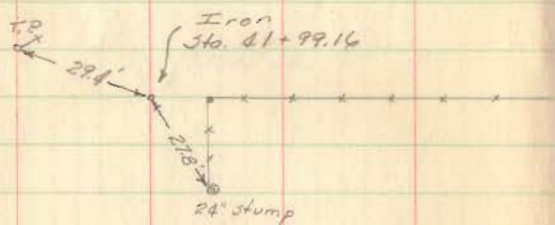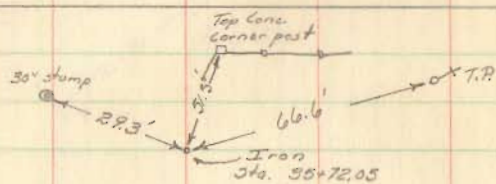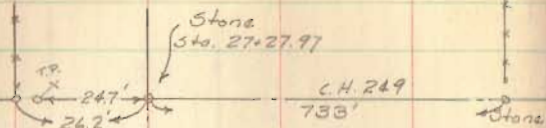

CIRA  
Geeslin  
10-23-62

C. H. 32  
Witnessed Irons

4

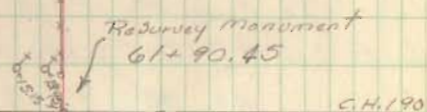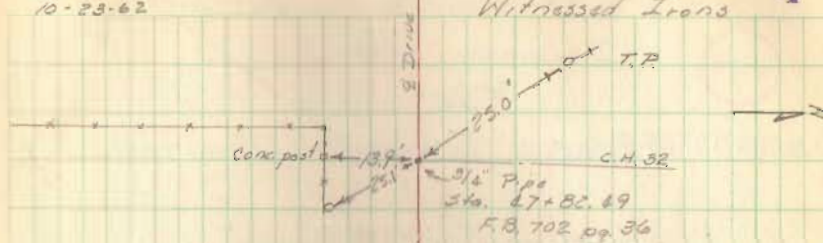

N  
↑

C.H. 32