

Road 262

Wilgus 12-22-38.
Jones
Lee

Sta 7+50 Mon. set 25' L. 25' R.

Sta 4+05.4 Mon. set 25' L. only


Sta 4+00 Mon. set 25' L. 25' R.

Sta 1+00 Mon. set 25' L. 25' R.

Surveyed according to The Way that
The Big 4 R.R. Co dedicated for Road

Deed Book (139-394) (139-74)

35

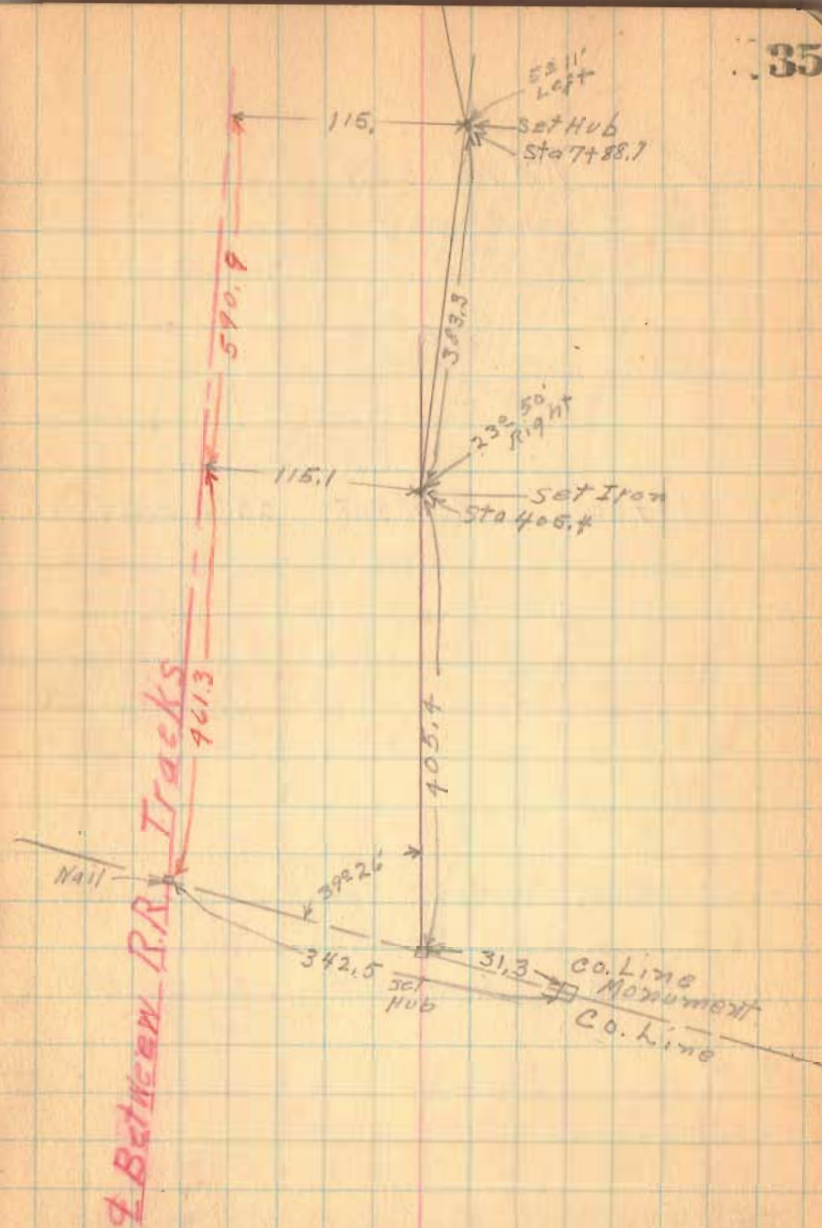

5083

INDEXED ON MAP

Road 162

Sta 18+00 Mont set 25' L & 25' R.

Sta 13+00 Mont Set 25 L & 25 R.

Sta 12+00 Mont set 25 L & 25 R.

Sta 8+00 Mont Set 25' L & 25' R.

