

Lee Surveying and Mapping Co.



CLAYTON M. LEE, P.S.
JEFFREY I. LEE, P.S.

855 East Sandusky Avenue
Bellefontaine, Ohio 43311
Phone 593-5780



Farm Surveys • Lot Surveys • Topography • Subdivisions • Construction Layout

EARICK TO FLEECE

Lying in Sections 25 and 31, T-4, R-14, B.T.M., Liberty Township,
Logan County, Ohio.

Being out of that land lying in the name of Steven Earick, as deeded and described in Volume 402, Page 876 of the Logan County Records of Deeds and lying adjacent to and abutting those 2 tracts lying in the name of Charles Fleece (1 Acre-Volume 401, Page 685 and 0.50 Acre-Volume 404, Page 547) and being more particularly described as follows:

Beginning at an iron rod found marking the northeast corner of the Charles Fleece 1.00 acre tract (Volume 401, Page 685). This point lying S 86°-01' E, a distance of 258.85 feet from the center-line of U.S. Route 68.

THENCE, continuing S 86°-01' E, with the Earick north line, a distance of 120.56 feet to an iron rod.


THENCE, parallel to the east line of said 1.00 acre, S 4°-10' E, a distance of 255.0 feet to an iron rod.

THENCE, with the south line extended easterly of said Fleece lot (0.50 Acre-Volume 404, Page 547), N 86°-01' W, a distance of 120.56 feet to an iron rod set on the southeast corner of said 0.50 acre tract.

THENCE, with the east lines of said 0.50 acre and 1.00 acre, N 4°-10' W, a distance of 255.00 feet to the point of beginning.

Containing 0.699 acre of which 0.485 acre is in Section 25 and 0.214 acre is in Section 31.

Prepared by:


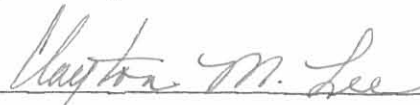


Clayton M. Lee
Registered Surveyor No. 6181
October 1, 1984

7219 110

INDEXED ON MAP

L-237

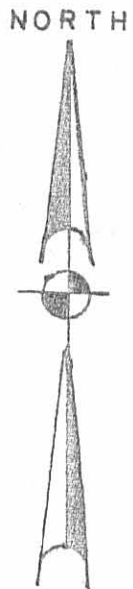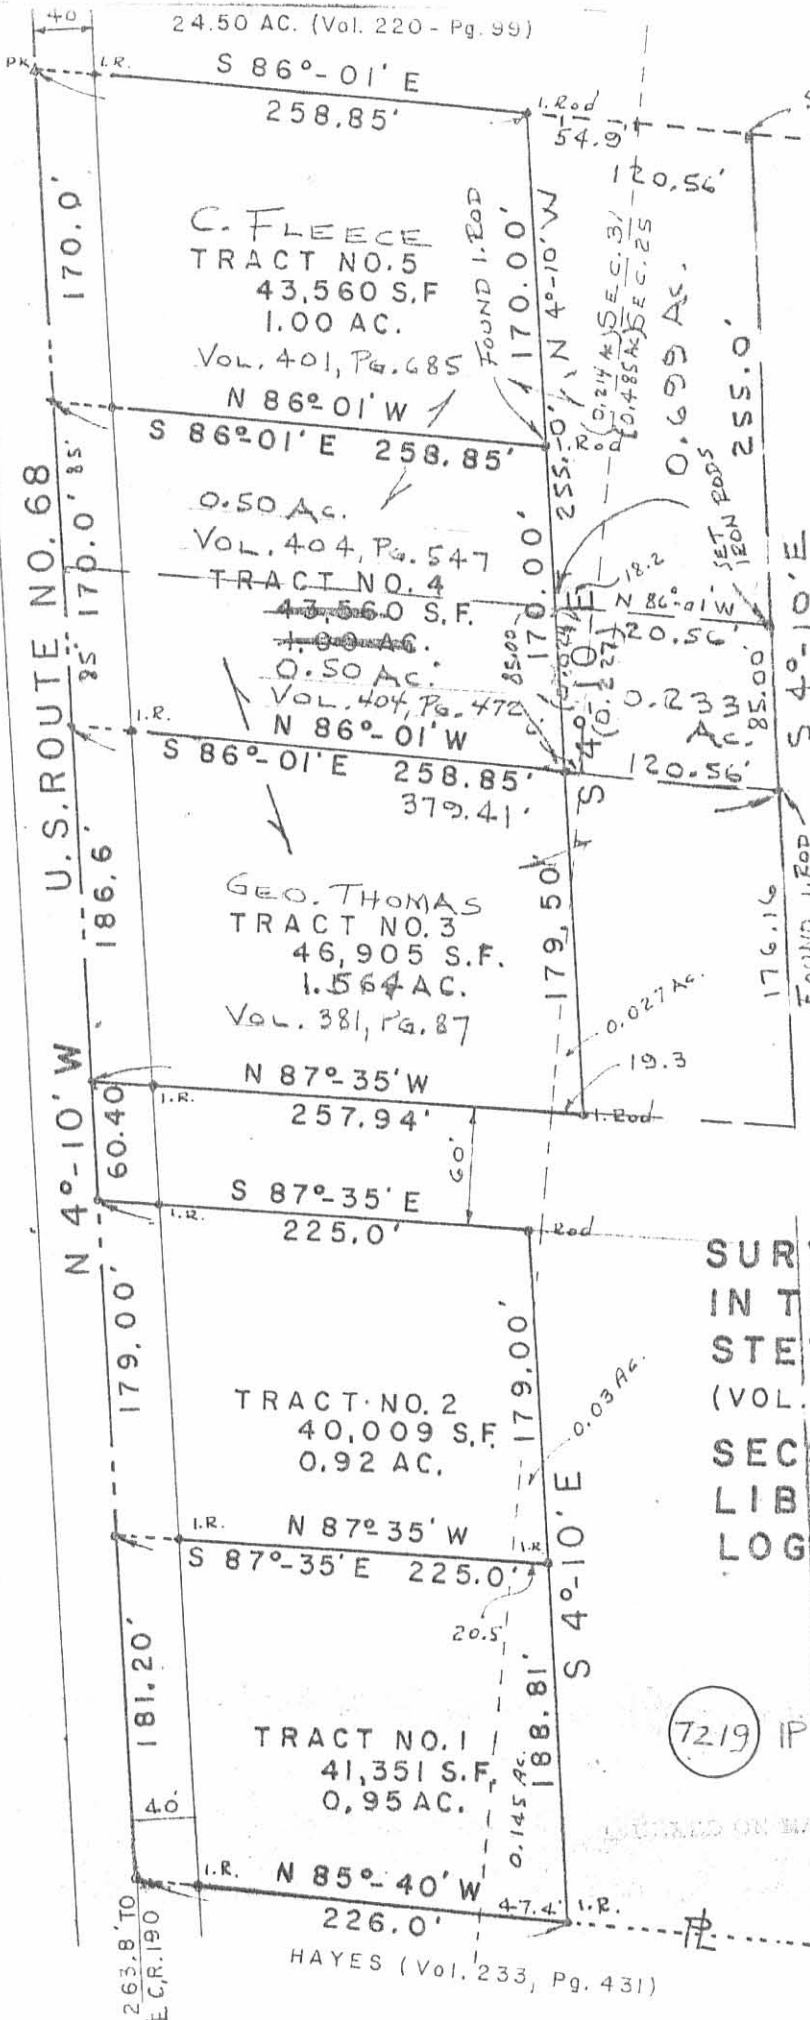

STEVEN EARICK
VOL. 402, PG. 876

SCALE 1"=100'



**SURVEY OF 2 TRACTS
IN THE LANDS OF
STEVEN EARICK**
(VOL. 402, PG. 876)
SECS. 25 & 31, T-4, R-14, B.T.M.
LIBERTY TOWNSHIP
LOGAN COUNTY, OHIO

SURVEYED BY:
Clayton M. Lee
Clayton M. Lee
Ohio Reg. Surveyor 6181
3-15-77
REV. 9-28-84

7219 IP

Lee Surveying & Mapping Co.
855 E. Sandusky Ave.
BELLEFONTAINE, OHIO 43311
(513) 593-5780

HAYES (Vol. 233, Pg. 431)