


PART LOT 19
SOUTH GATE ACRES
AUGUST 17, 1979

The following described real estate situated in Liberty Township, Logan County, Ohio and being part of lot 19 of South Gate Acres as shown in Logan County Recorders file cabinet A, slide 333 and more particularly described as follows:

Beginning at an iron bar in the north line of Buckeye Drive at the southeast corner of said lot 19; thence with the north line of said drive and the south line of said lot 19 N.86°47'W. 126.24 feet to an iron bar; thence with a curve to the right having a central angle of 88°36' and a radius of 25.00 foot, a chord bearing N.64°05'W. 19.29 feet to an iron bar; thence N.44°46'E. 217.14 feet to an iron bar at the northeast corner of said lot 19; thence with the east line of said lot S.3°13'W. 169.93 feet to the place of beginning.

7310 10

INDEXED ON MAP

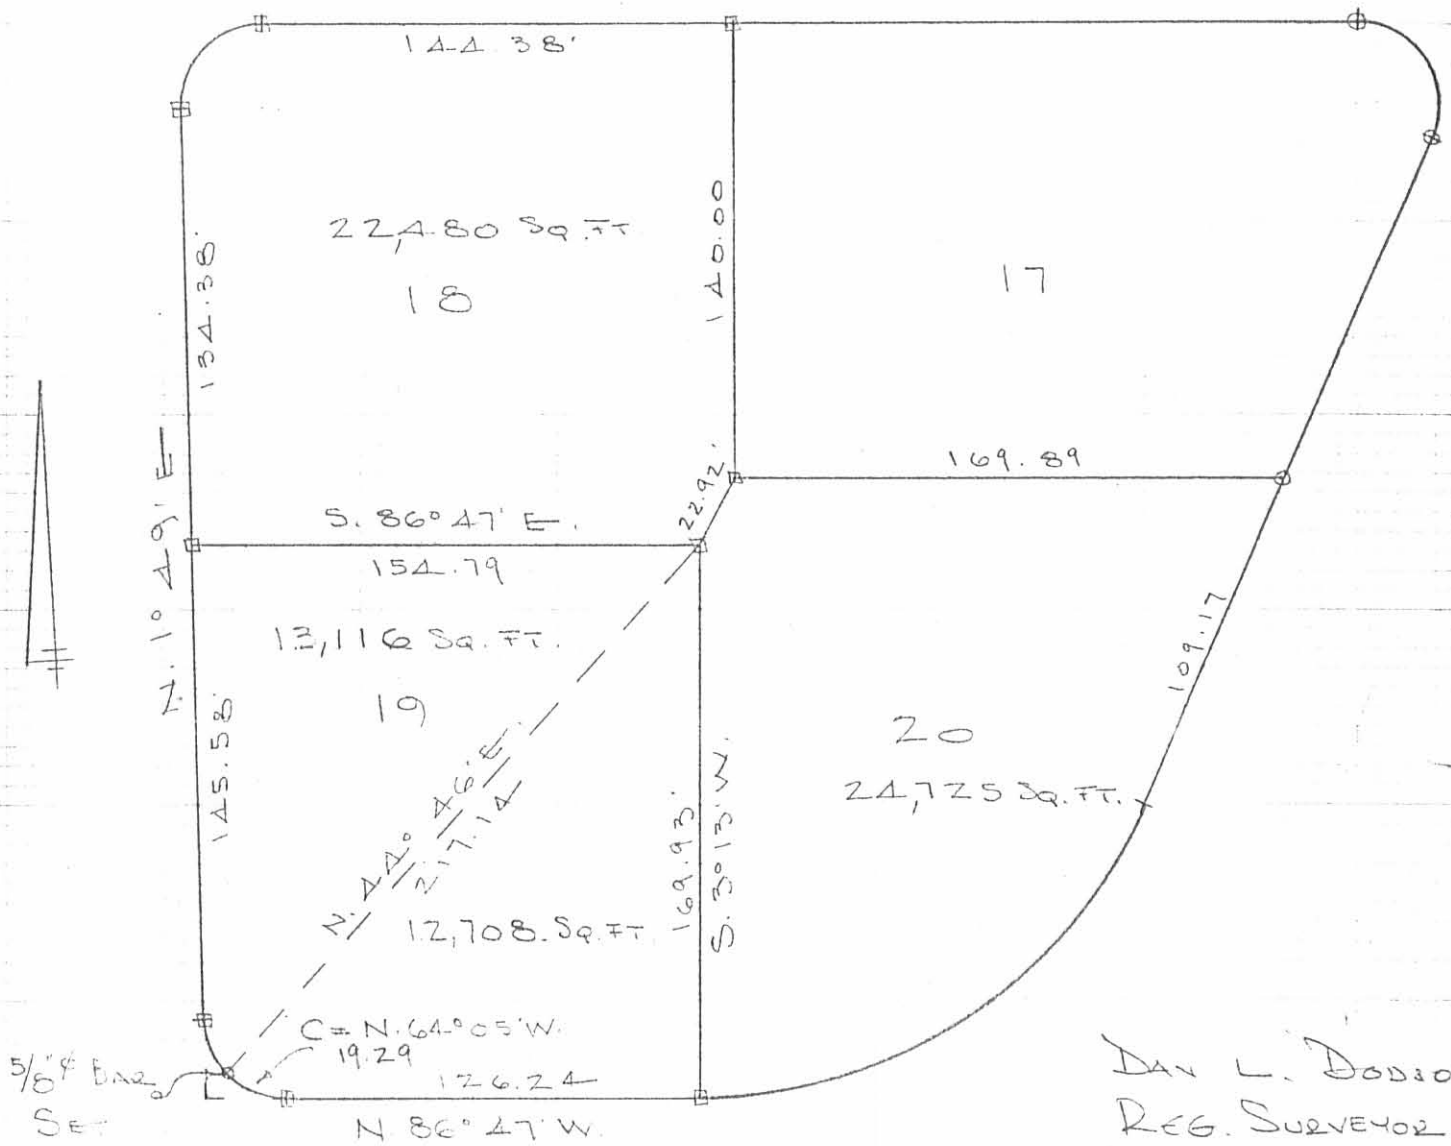

DAN L. DODSON
 REG. SURVEYOR 4270
 BELLEFONTAINE, O

SURVEY OF
 LOT 18-19-20
 SOUTHGATE ACRES
 SEC. 31 T. 4 R. 14
 LIBERTY TOWNSHIP
 LOGAN COUNTY, OHIO
 AUGUST 17, 1979
 SCALE 1" = 60'
 □ = 5/8" SQ. BAR FOUND

7310 IP

INDEXED ON MAP