BOURGEOIS SURVEY

V. M. S. 9883 McArthur Township August 2, 1958

The following described real estate situated in McArthur Township,
Logan County, Chio and being part of Virginia Military Survey 9883 and
more particularly described as follows:


Commencing at a point in the center of County Highway No. 49 at the northeast corner of William Rush's 115.98 acre tract; thence with the centerline of said County Highway No. 49 S. 6°-00° E. 851 feet to an iron pin, said pin being the beginning point of this description; thence continuing with said center line S. 6°-00° E. 300.0 feet to an iron pin; thence S. 83°-39° W. 317.7 feet to a post; thence N. 6°-39° W. 298.1 feet to a post; thence N. 83°-17° E. 321.0 feet to the place of beginning.

Containing 2.19 acres more or less.

115,100

on Plat Brook

3 083

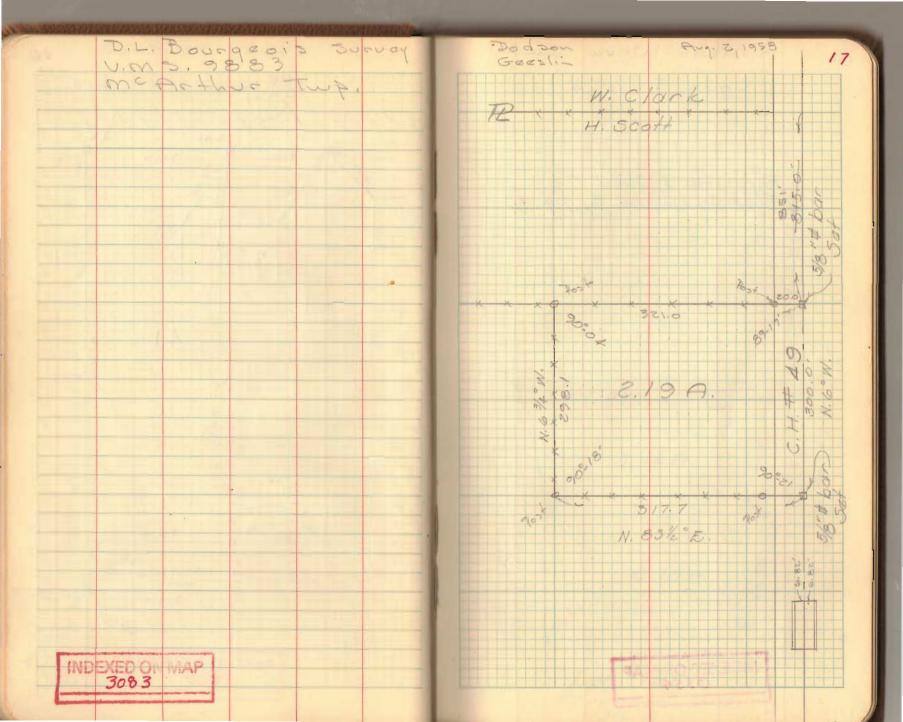

	THE PROPERTY OF THE PARTY OF TH
D. L. Bourgeois Podson	Aug - 2, 1958
Box 178	
Ballatowharing, O	
	0 4
	U
X	
70" 321.0'	2000 18 A Iron
90'07	800,17
90-15	48.
92-27	in in
90-5	300
359-55	9
1000 000	ut.
00 B N 83 ± E 317.7	15 got 7/8 Imm
Port	
BK 3 Pg 17	
	685 6.82
INDEXED OF MAP.	
3003	