

FB 702

C.H. No. 238  
McArthur Twp.

40' R/w


stakes set for telephone poles.

D.G. Gilbert  
D. Lewis

7-21-58  
Cool-Rail

39

C.H. No. 37

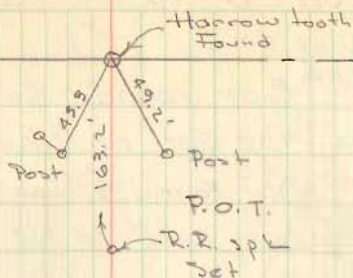

C.H. No. 238

3466

INDEXED ON MAP

Iron Found  
(Handle looking)

S.R. No. 274

S.R. #  
274

