

TURNER SURVEY  
V.M.S. 9883  
McARTHUR TOWNSHIP

May 22, 1973


The following described real estate situated in McArthur Township, Logan County, Ohio and being part of Virginia Military Survey 9883 and more particularly described as follows:

Beginning at an iron bar in the center of Township Road No. 37 at the northeast corner of Jenna O. Poirier's 1.00 acre tract, said iron bar being Station 331+29 as shown in Logan County Engineer's Field Book 687, Page 24; thence with the centerline of said Township Road No. 37, N. 79° 07' E. 215.00 feet to a railroad spike; thence S. 10° 53' E. 311.20 feet to an iron bar, passing an iron bar at 30.0 feet; thence S. 79° 07' W. 214.80 feet to an iron bar at the southeast corner of said Poirier's 1.00 acre tract; thence with said Poirier's east line N. 10° 56' W. 311.20 feet to the place of beginning.

Containing 1.54 acres more or less.

The above described tract being part of Nellie M. Turner's 75.63 acre tract.



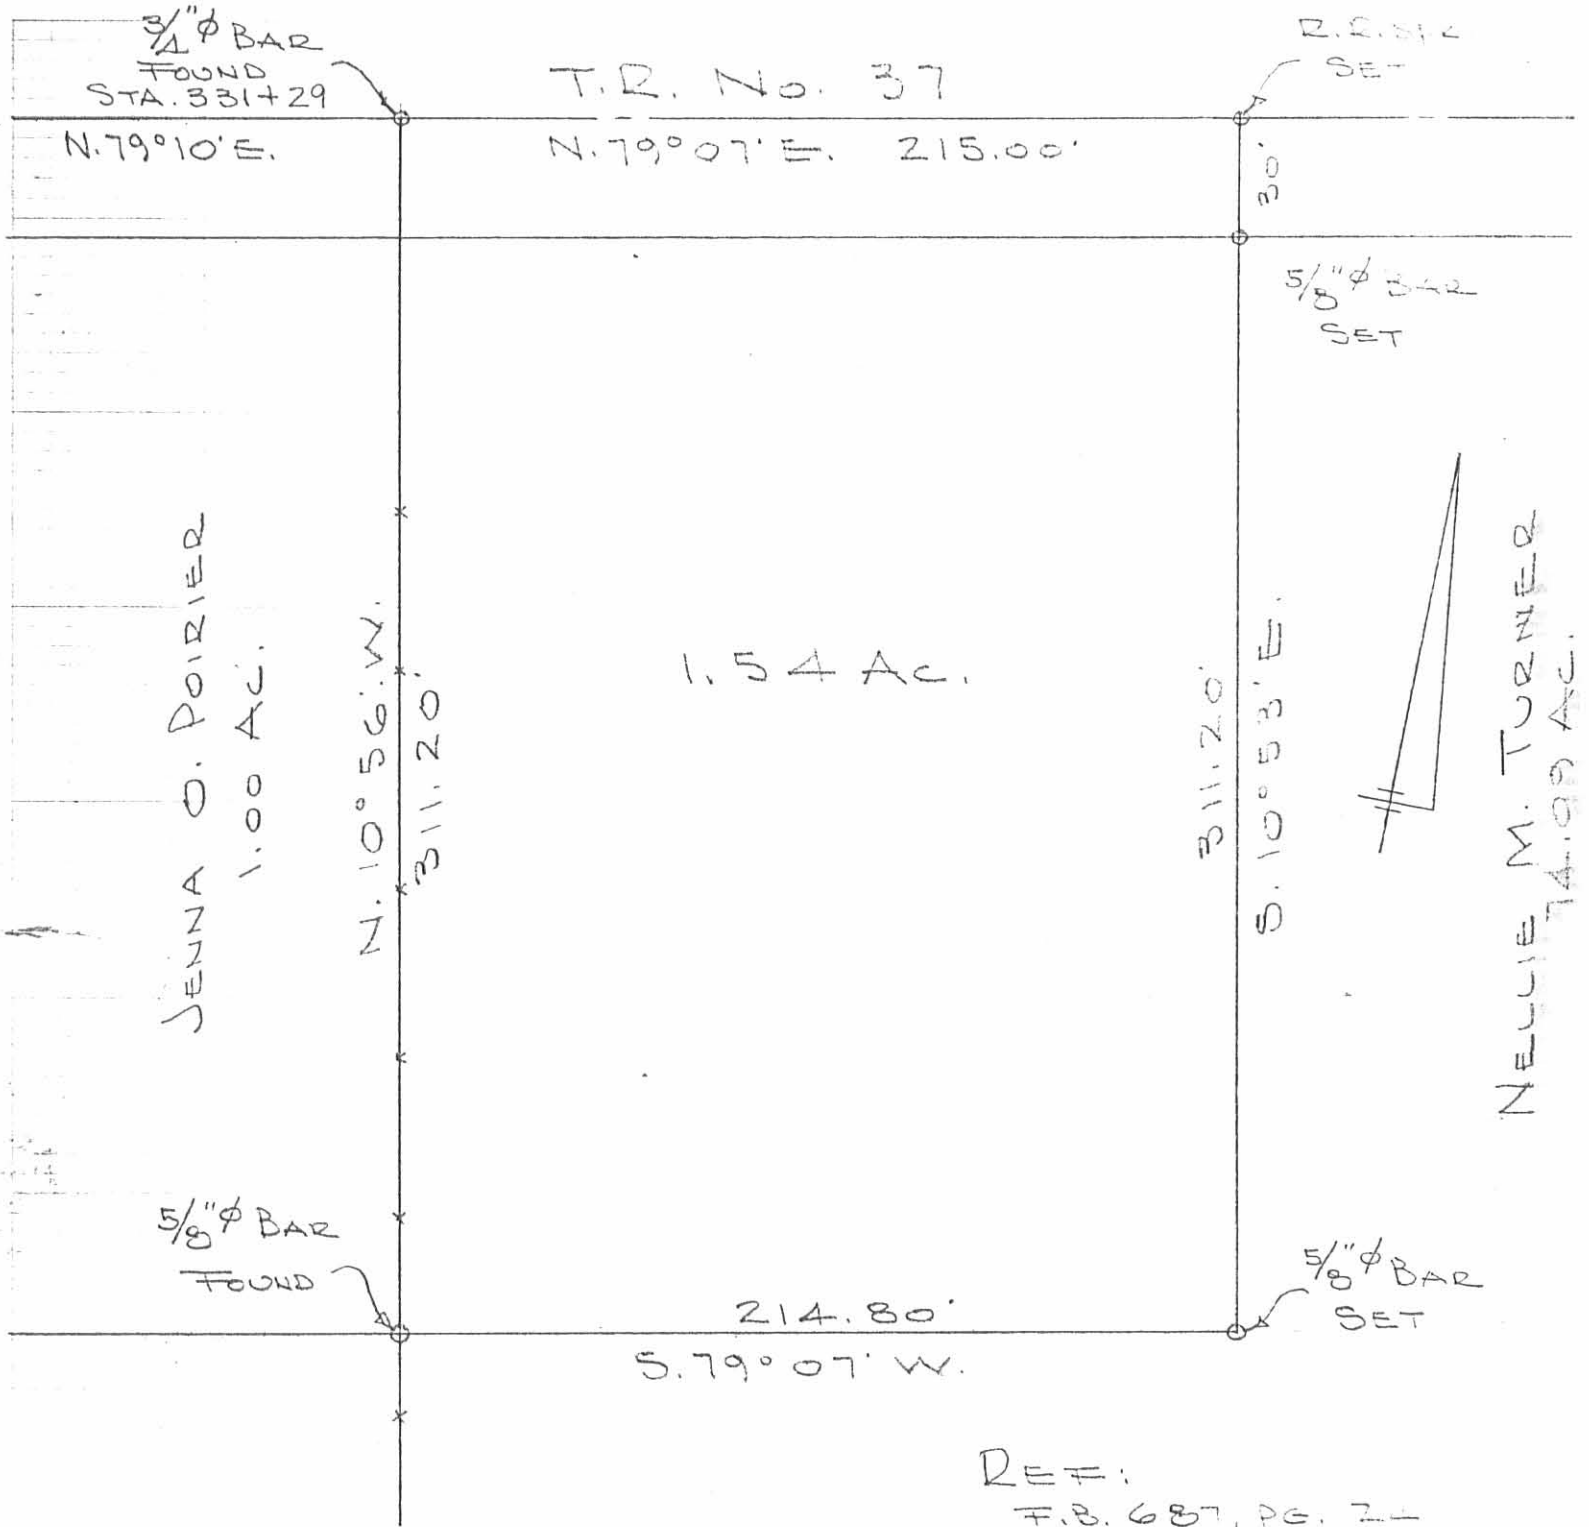

T.R. No. 37  
 N. 79° 07' E. 215.00'

N. 79° 10' E.

R. 2. 2. 1/2 SET

30'

5/8" φ BAR SET

JENNA O. POIRIER  
 1.00 AC.

N. 10° 56' W.  
 311.20'

1.54 AC.

311.20'  
 S. 10° 53' E.

NEJJIE M. TURNER  
 0.54 AC.

5/8" φ BAR FOUND

214.80'  
 S. 79° 07' W.

5/8" φ BAR SET

REF:  
 F.B. 687, PG. 24  
 BK 3, PG. 36

TURNER SURVEY  
 V.M.S. 9883  
 MCARTHUR TOWNSHIP  
 LOGAN COUNTY, OHIO  
 MAY 22, 1973  
 SCALE 1" = 50'

INDEXED ON MAP  
 5323 1P

DAN L. DODSON  
 REG. SURVEYOR 4270  
 BELLEFONTAINE, OHIO  
 BK 20/6

TURNER SURVEY  
V.M.S. 9883

McArthur Twp

See F.B. 687 pg. 24 for  
T.R. 37

See Bk 3 pg. 36 for  
Hower Survey

Note R.R. spikes set @ 210.00' &  
215.00' from 3/4" P @ Sta. 331+29  
R @ 215.00'

INDEXED ON MAP  
5323

Dutton  
Artes  
McCounty

MAY 22, 1973.  
70°  
RAW

06

