

Boyer to Burnside Survey

Aug., 1973

Being situated in M<sup>c</sup>Arthur Township, Logan County, Ohio; and being a part of V.M.S. 9906.

Tract One:

Being all of lots 7, 8, 9, and 20 of Bates Subdivision.

Tract Two:

Beginning at an iron at the southeast corner of lot 7 of Bates Subdivision.

Thence with the extension of the south line of said lot 7 N 85°-00'E 937.0 feet to an iron in the west line of a 50.00 acre tract.

Thence with the west line of said 50.00 acre tract N 52°-14'W 1455.0 feet to a corner post.

Thence S 84°-17'W 931.0 feet to the northeast corner of lot 20 of Bates Subdivision.

Thence with the east line of Bates Subdivision S 5°-00'E 1443.6 feet to the place of beginning.

Containing 31.03 acres more or less. Being surveyed from a 59.11 acre tract.

---


Owen K. Shirk  
Surveyor 4271

1D

5333

INDEXED ON MAP

BOYER TO BURNSIDE SURVEY  
 McARTHUR TWP., LOGAN CO., OHIO  
 V.M.S. 9906 - 1" = 200'

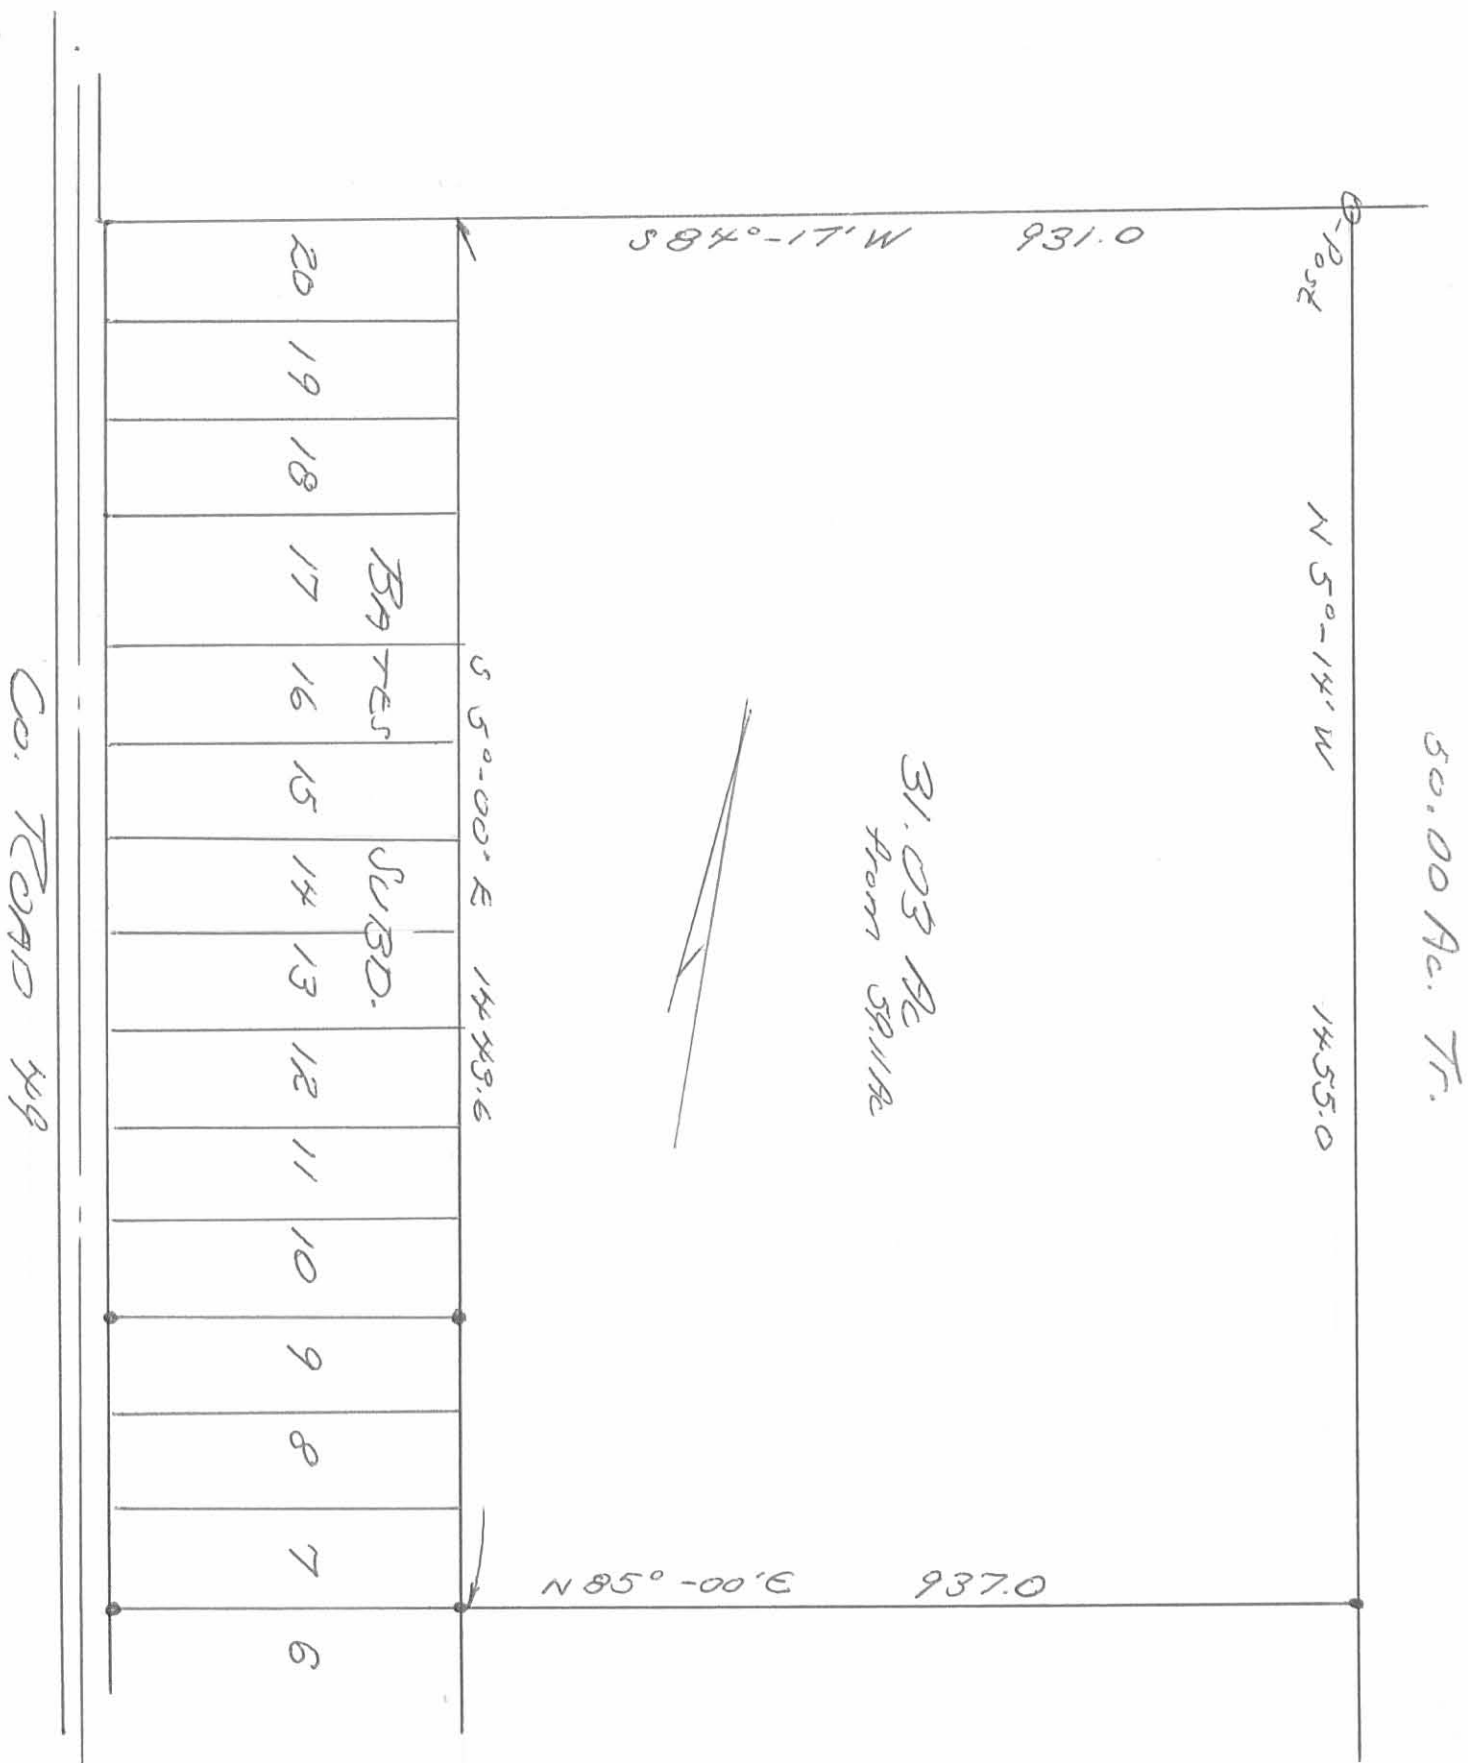

Owen K. Shirk  
 Surveyor 4271  
 Aug 21, 1973

IP  
 5333

INDEXED ON MAP

N. 64°-13' E. 985.7'

370'

20 100 105.6

19 100 100

18 100 100

17 138 138

16 100 100

15 100 100

370'

400'

C.H. No. 49

N. 5°-00' W. 8058.0'

8048.6'

S. 5°-27' E. 8571.0'

59.16A.

1.0A

C.H. No. 37

S. 83°-54' W. 1343.4

### BATES SURVEY

V.M.S. 9906

MCARTHUR TWP. LOGAN Co.

OHIO

5333

S-123

S-123

Bates Survey  
on Arthur Twp.

See Co Eng Fd 552 pg. 59


C.H. # 37 " " " " 687 pg. 24

C.H. # 49 " " " " 559 pg. 13

INDEXED ON MAP  
5333

Dodson-  
McGinnis

41

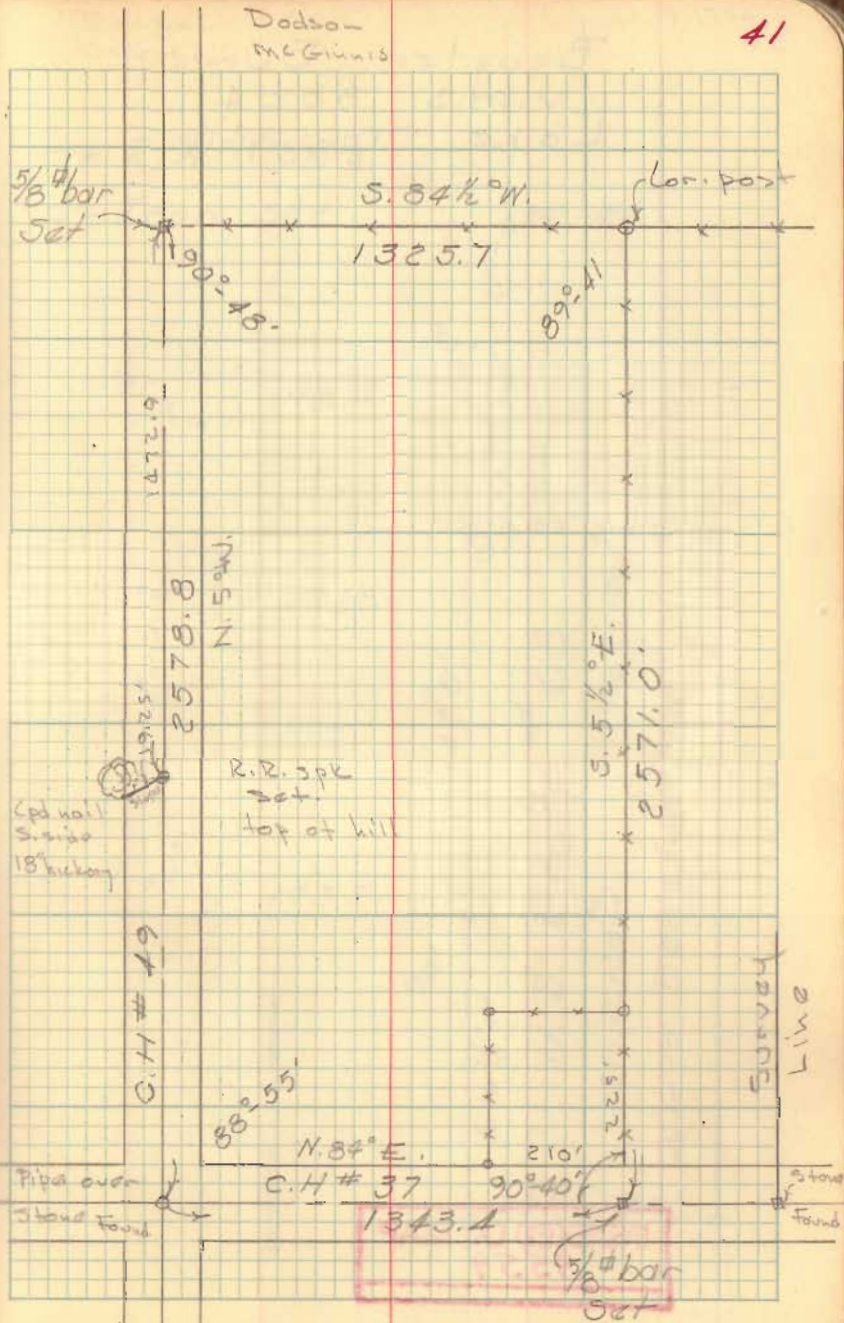









13

14

15

16

17

18

19

20

100.0

34.0

80.0

55.1'

100.0

2.25 ft

glope 19.25

gapped well inside 18' Hickory

3.8  
5.4  
9.2

5.5 pg 5 JF

INDEXED ON MAP  
5333